

A PARCEL LOCATED IN THE SOUTHWEST QUARTER OF SECTION 26,
TOWNSHIP 3 SOUTH, RANGE 68 WEST OF THE SIXTH PRINCIPAL MERIDIAN,
CITY AND COUNTY OF DENVER, STATE COLORADO



C1.2 WASTEWATER COVER SHEET & NOTES
C4.0 OVERALL GRADING PLAN
C4.1 DETAILED GRADING PLAN
C4.2 DETAILED GRADING PLAN
C4.3 DETAILED GRADING PLAN
C5.0 UTILITY PLAN
C6.0 STORM PLAN & PROFILE
C6.1 STORM PLAN & PROFILE
C6.2 STORM PLAN & PROFILE
C6.3 DETENTION VAULT PLAN
C6.4 STORM DETAILS
C6.5 STORM DETAILS
DR1 DRAINAGE PLAN

By: Ted Swan for and on behalf of Ware Malcomb
Date: 12/11/2019
Based on information provided by:
Surveyor: Jeffrey J. Mackenna PLS: 34183
Company: Falcon Surveying Inc.
Date(s): 10/29/2019


This "drawing" is a record document prepared from and based upon, in part, information provided by others. Neither Ware Malcomb nor the Engineer of Record has verified the accuracy of this information and shall not be responsible for any errors or omissions which may be incorporated herein as a result.

THESE CONSTRUCTION DRAWINGS FOR **PLATTE VALLEY APARTMENTS - RENOVATION & ADDITIONS** WERE PREPARED BY ME (OR UNDER MY DIRECT SUPERVISION) IN ACCORDANCE WITH THE REQUIREMENTS OF THE STORM DRAINAGE AND SANITARY CONSTRUCTION DETAILS AND TECHNICAL SPECIFICATIONS AND THE STORM DRAINAGE DESIGN AND TECHNICAL CRITERIA OF THE CITY AND COUNTY OF DENVER.

NO WORK IS AUTHORIZED WITHOUT
A PRE-CONSTRUCTION MEETING AT
WHICH YOU WILL RECEIVE A COPY
OF THE CITY AND COUNTY OF
DENVER STAMPED AND APPROVED
SET OF PLANS

PLEASE CALL 303-446-3722 TO
SCHEDULE A PRE-CONSTRUCTION
MEETING AFTER YOUR PLANS HAVE
BEEN APPROVED

City and County of Denver Development Services Site Engineering			
Checked for General Compliance with applicable Denver Criteria, Rules, Regulations and Standards.			
APPROVED (if validly signed)			
This approval becomes void if construction is not started within one (1) year of the approval date.			
<div style="border-bottom: 1px solid black; margin-bottom: 5px;"></div> Approved by		<div style="border-bottom: 1px solid black; margin-bottom: 5px;"></div> Date	
<div style="border-bottom: 1px solid black; margin-bottom: 5px;"></div> (Note: Signature in Print)		<div style="border-bottom: 1px solid black; margin-bottom: 5px;"></div> Review Engineer	
APPROVED AS TO FORM. ENGINEERING CALCULATIONS, DRAWINGS AND DESIGN ADEQUACY ARE ACCEPTED BASED UPON THE PROJECT ENGINEER'S ATTACHED SEAL OF REGISTRATION.			
THIS APPROVAL IS FOR PRIVATE STORM IMPROVEMENTS			
CALL THE UTILITY NOTIFICATION CENTER OF COLORADO AT			
811			
THREE (3) BUSINESS DAYS IN ADVANCE BEFORE DIGGING, GRADING OR EXCAVATING FOR MARKING OF MEMBER'S UNDERGROUND UTILITIES			
(Project Engineer's Seal, Signature and Date)			
DS PROJECT NO.		2017-PROJMSTR-0000589 / 2017-SSPR-0000099	
PROJECT NAME:		PLATTE VALLEY APARTMENTS - RENOVATION & ADDITIONS	
DESIGNED BY	B/M	DATE	11/22/2017
DRAWN BY	J/P	DATE	11/22/2017
CHECKED BY	T/LS	DATE	11/22/2017
SHEET 1 OF 13		C1.2	

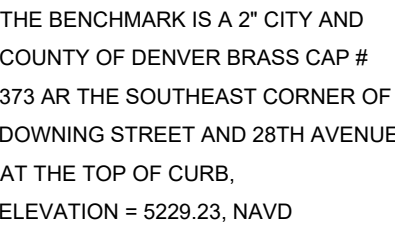

CALL UTILITY NOTIFICATION CENTER
OF COLORADO
811
CALL 2 BUSINESS DAYS IN ADVANCE
BEFORE YOU DIG, GRADE OR EXCAVATE
FOR THE MARKING OF UNDERGROUND
MEMBER UTILITIES.

[illegible]

PLATTE VALLEY APARTMENTS RENOVATION & ADDITIONS

WASTEWATER COVER SHEET & NOTES

Date: 08/02/2018

Job No.: 16090

Sheet


C1.2

Sheet 0

DS PROJECT NO.2017-PROJ-MSTR-0000589 / 2017-SSPR-0000099

PROJECT NAME:PLATTE VALLEY APARTMENTS - RENOVATION & ADDITIONS

DESIGNED BY	BM	DATE	11/22/2017	DATE ISSUED	11/22/2017	DRAWING NO.	
DRAWN BY	JP	DATE	11/22/2017				
CHECKED BY	TLS	DATE	11/22/2017	SHEET 6 OF 13		C5.0	

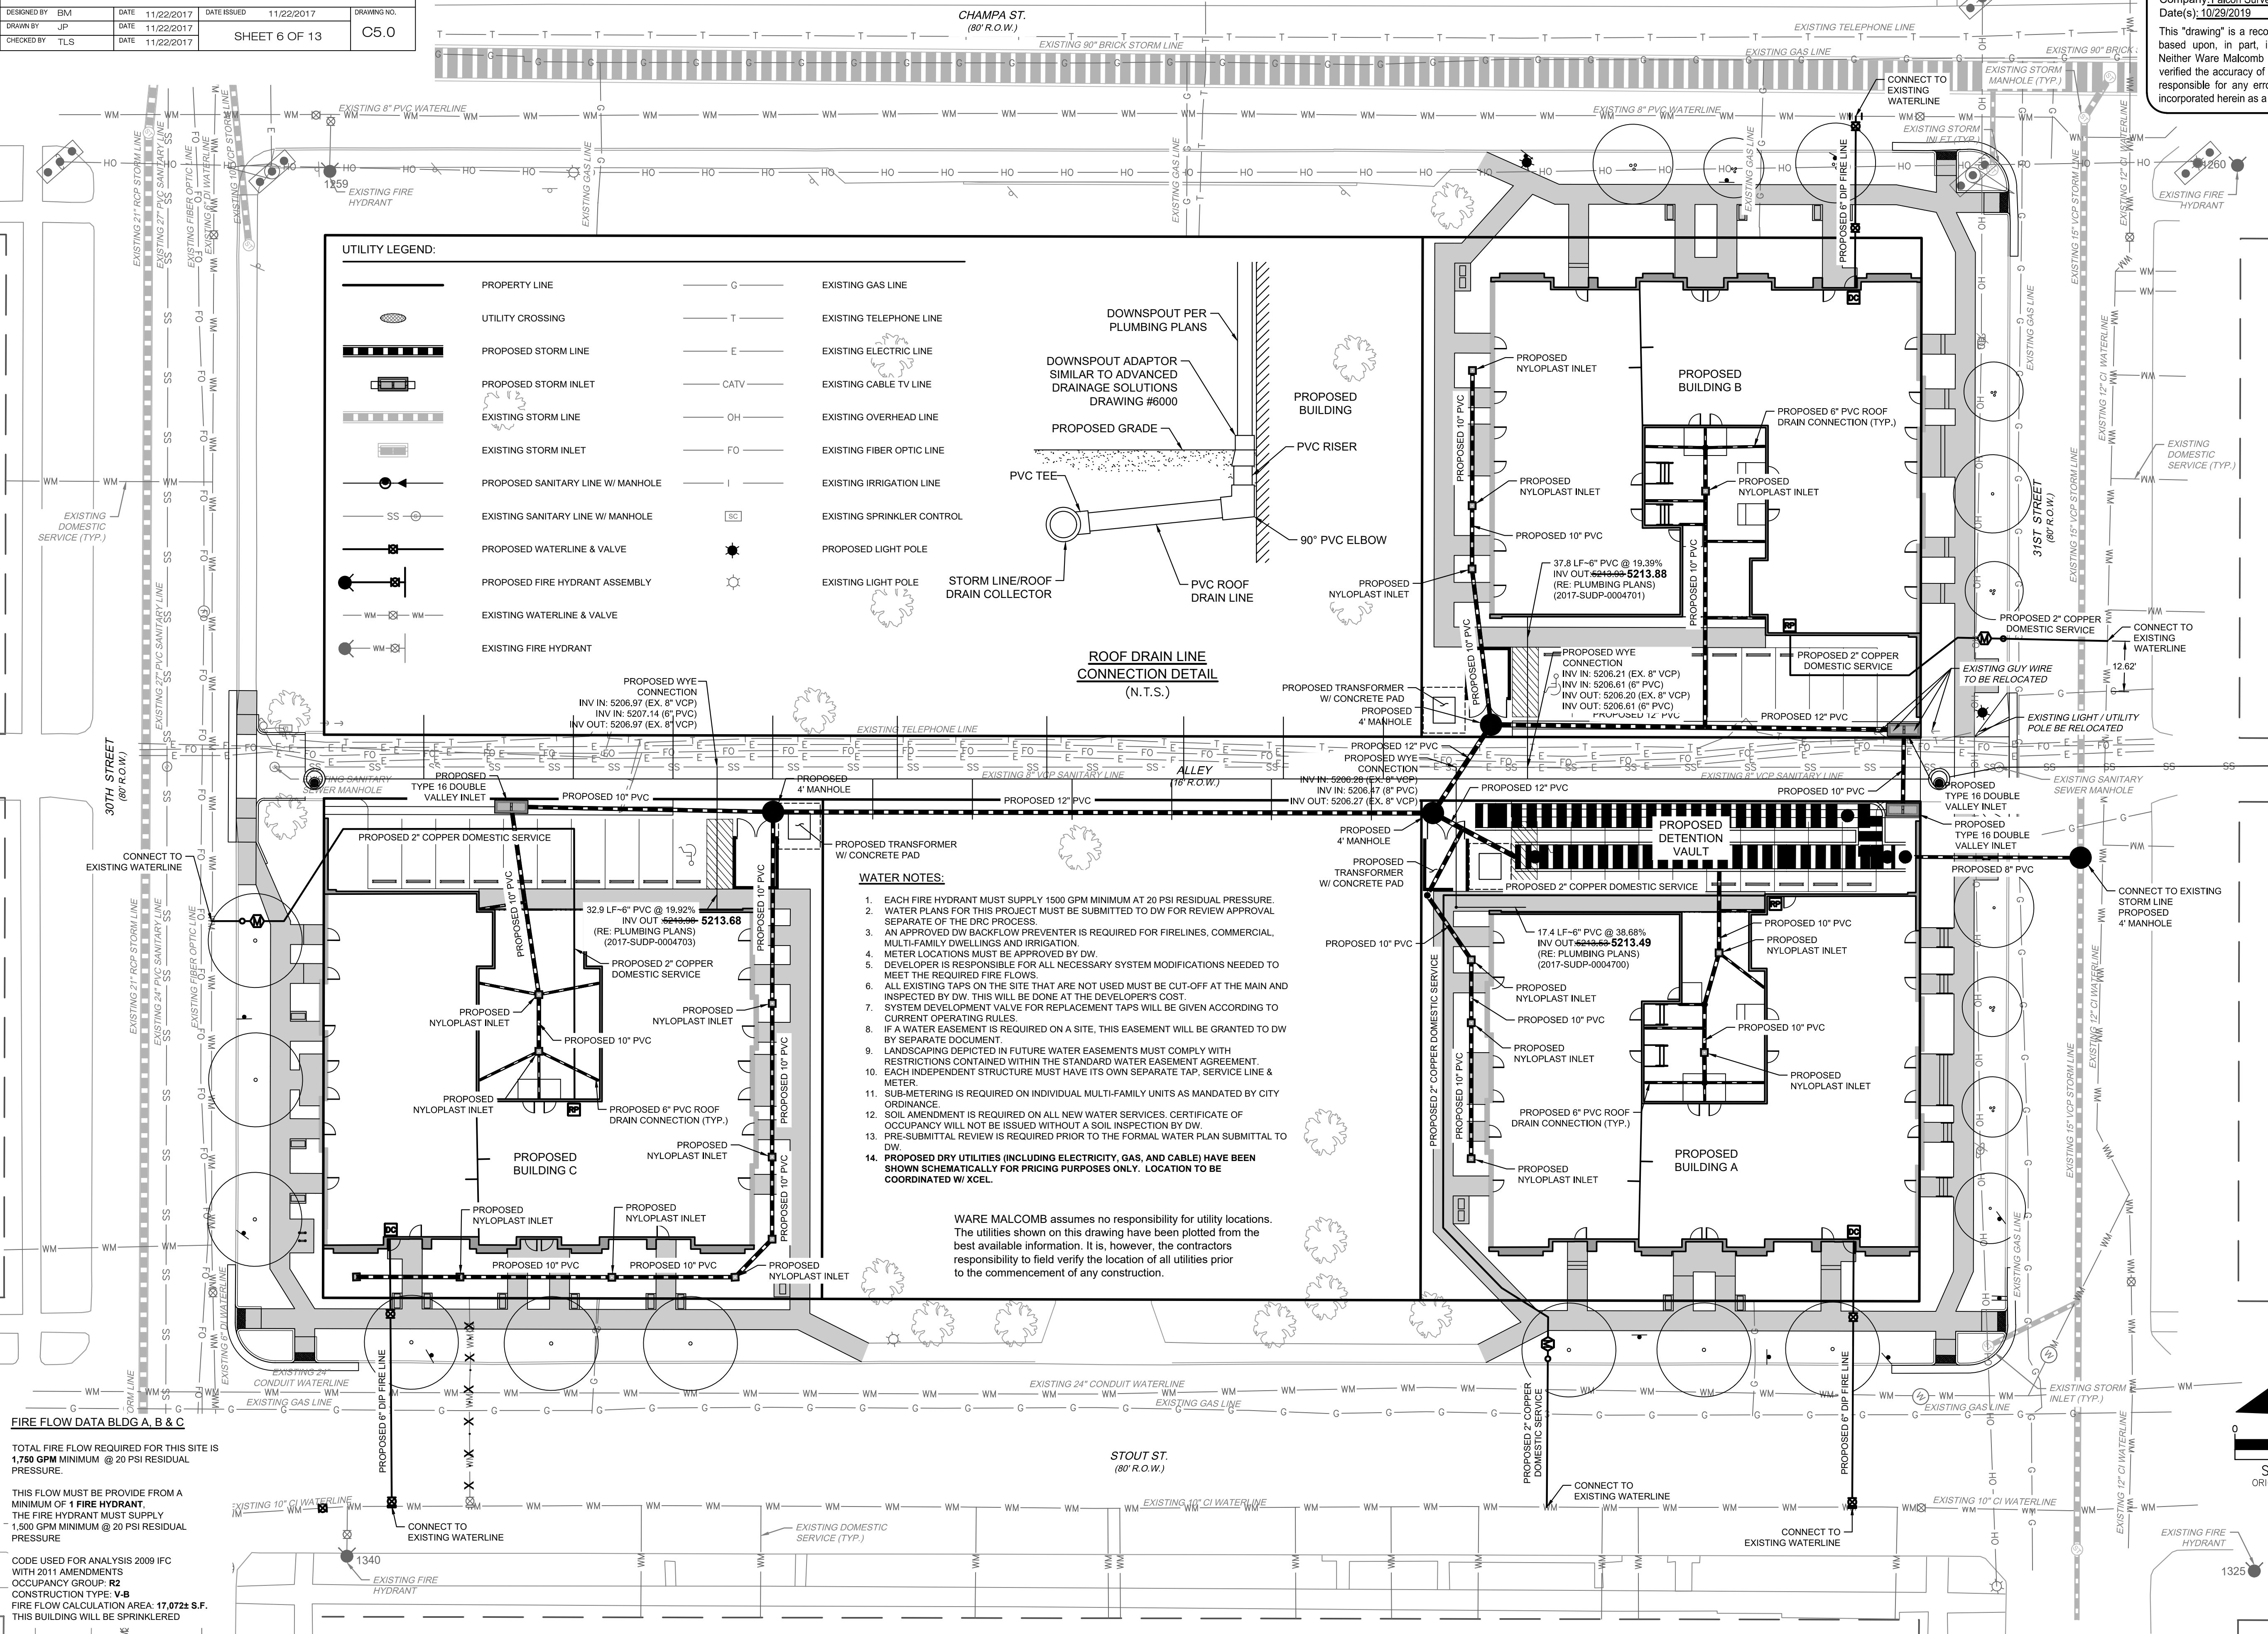


RECORD DRAWING

By: Ted Swan for and on behalf of Ware Malcomb
Date: 12/11/2019
Based on information provided by:
Surveyor: Jeffrey J. Mackenna
Company: Falcon Surveying Inc.
Date(s): 10/29/2019
This "drawing" is a record document prepared from and based upon, in part, information provided by others. Neither Ware Malcomb nor the Engineer of Record has verified the accuracy of this information and shall not be responsible for any errors or omissions which may be incorporated herein as a result.



JANSEN STRAWN
CONSULTING ENGINEERS
A WARE MALCOMB Company

45 WEST 2ND AVENUE
DENVER, CO 80223
P.303.561.3333
F.303.561.3339



Dec 11, 2019
FOR AND ON BEHALF OF
JANSEN STRAWN CONSULTING ENGINEERS, INC.

BENCHMARK:
THE BENCHMARK IS A 2" CITY AND COUNTY OF DENVER BRASS CAP # 373 AR THE SOUTHEAST CORNER OF DOWNING STREET AND 28TH AVENUE AT THE TOP OF CURB, ELEVATION = 5229.23, NAVD


CALL UTILITY NOTIFICATION CENTER OF COLORADO							811		CALL 2 BUSINESS DAYS IN ADVANCE BEFORE YOU DIG, GRADE OR EXCAVATE FOR THE MARKING OF UNDERGROUND MEMBER UTILITIES.				
							TLS	TLS	TLS	TLS	By	Date	
5	WASTEWATER REVISIONS						09/26/18						
4	ADDITION # 4						08/02/18						
3	CONSTRUCTION DOCUMENTS						06/27/18						
2	CONSTRUCTION DOCUMENTS						11/01/17						
1	90% CONSTRUCTION DOCUMENTS						10/06/17						
No.	Description of Revisions							Date					
												Designed By: BSM	Checked By: TLS

PLATTE VALLEY APARTMENTS
RENOVATION & ADDITIONS
UTILITY PLAN

Date: 08/02/2018
Job No.: 16090
Sheet:

C5.0

Sheet of




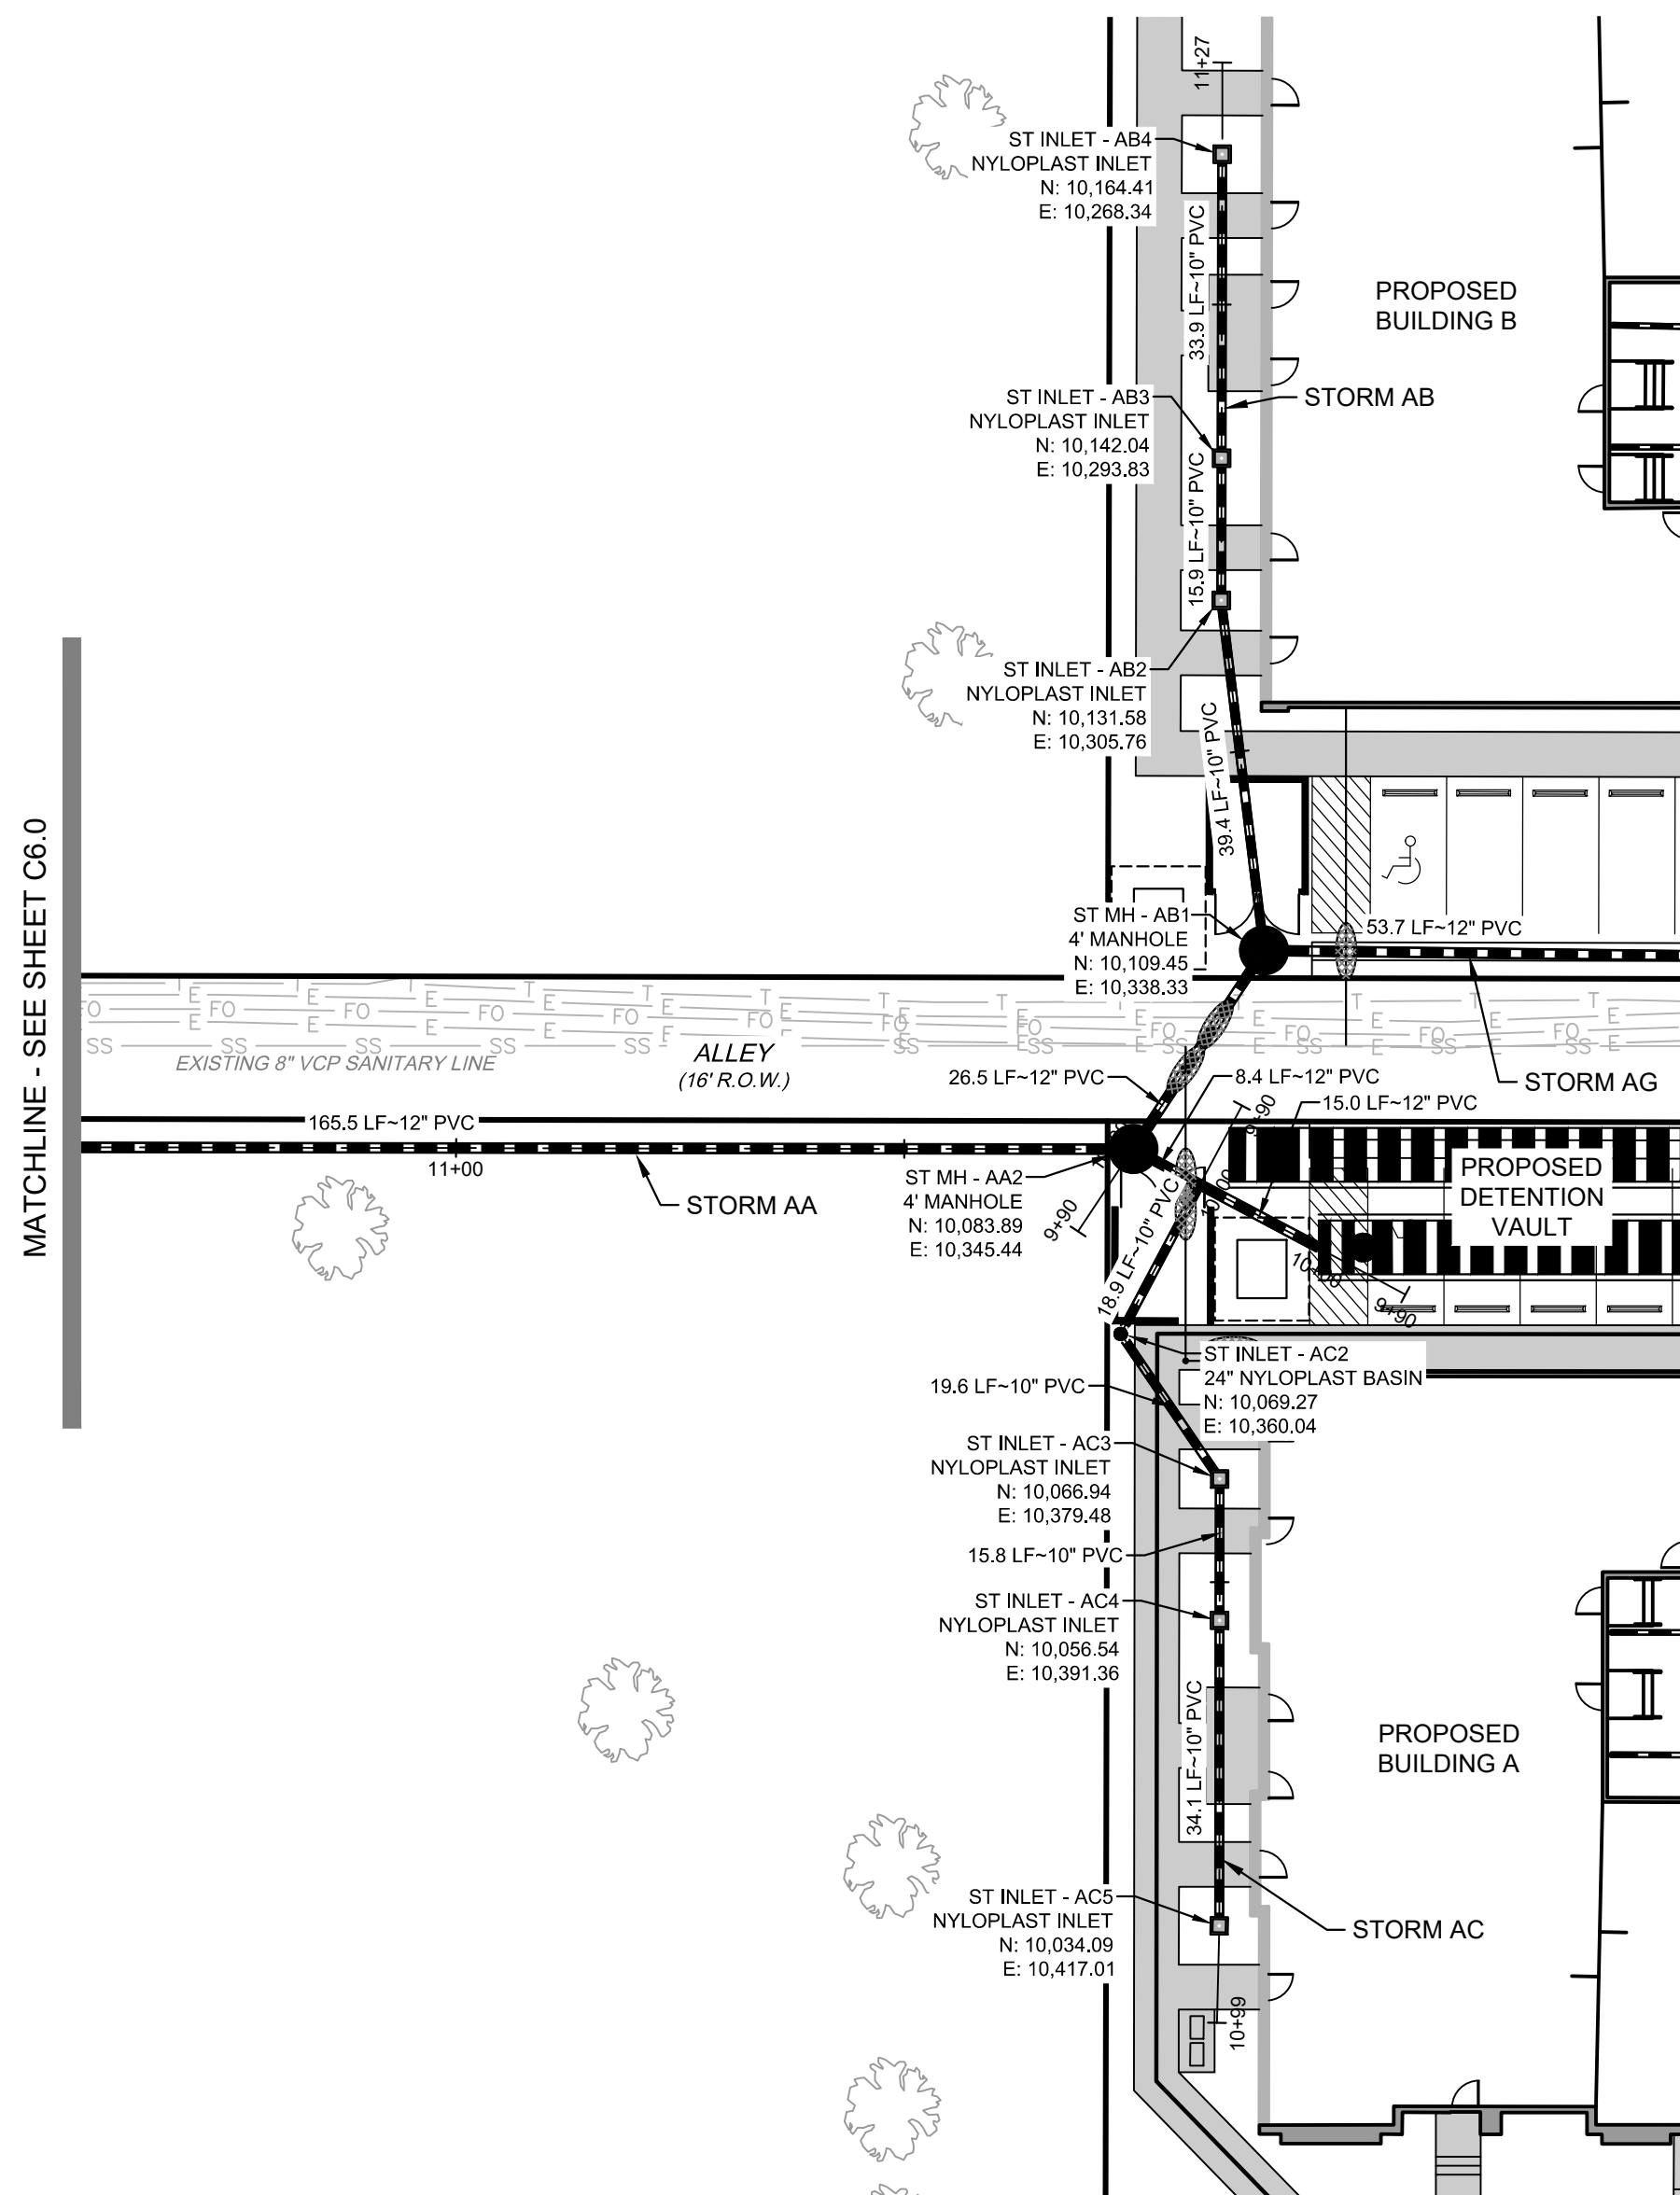


UTILITY LEGEND:

	PROPERTY LINE		EXISTING GAS LINE
	UTILITY CROSSING		EXISTING TELEPHONE LINE
	PROPOSED STORM LINE		EXISTING ELECTRIC LINE
	PROPOSED STORM INLET		EXISTING CABLE TV LINE
	EXISTING STORM LINE		EXISTING OVERHEAD LINE
	EXISTING STORM INLET		EXISTING FIBER OPTIC LINE
	PROPOSED SANITARY LINE W/ MANHOLE		EXISTING IRRIGATION LINE
	EXISTING SANITARY LINE W/ MANHOLE		EXISTING SPRINKLER CONTROL
	PROPOSED WATERLINE & VALVE		PROPOSED LIGHT POLE
	PROPOSED FIRE HYDRANT ASSEMBLY		EXISTING LIGHT POLE
	EXISTING WATERLINE & VALVE		
	EXISTING FIRE HYDRANT		

NOTES:

- 1) THE CONTRACTOR IS TO VERIFY THE ELEVATION OF ALL EXISTING UTILITIES WHERE NEW WORK WILL CONNECT AND NOTIFY THE ENGINEER IF THERE ARE ANY DISCREPANCIES.
- 2) INLETS ARE CONTROLLED AT CENTER OF BOX AT FLOWLINE.
- 3) MANHOLES ARE CONTROLLED AT CENTER OF MANHOLE.
- 4) ALL STORM LINES TO BE CLASS III REINFORCED CONCRETE UNLESS OTHERWISE NOTED.

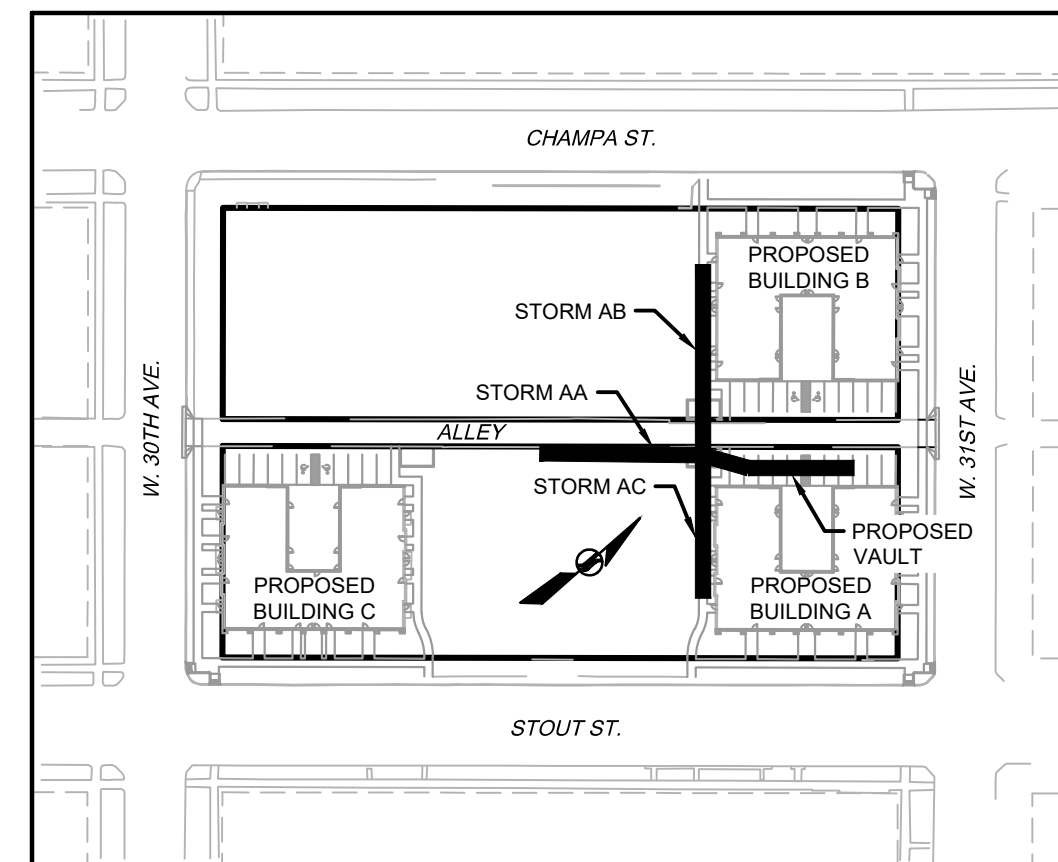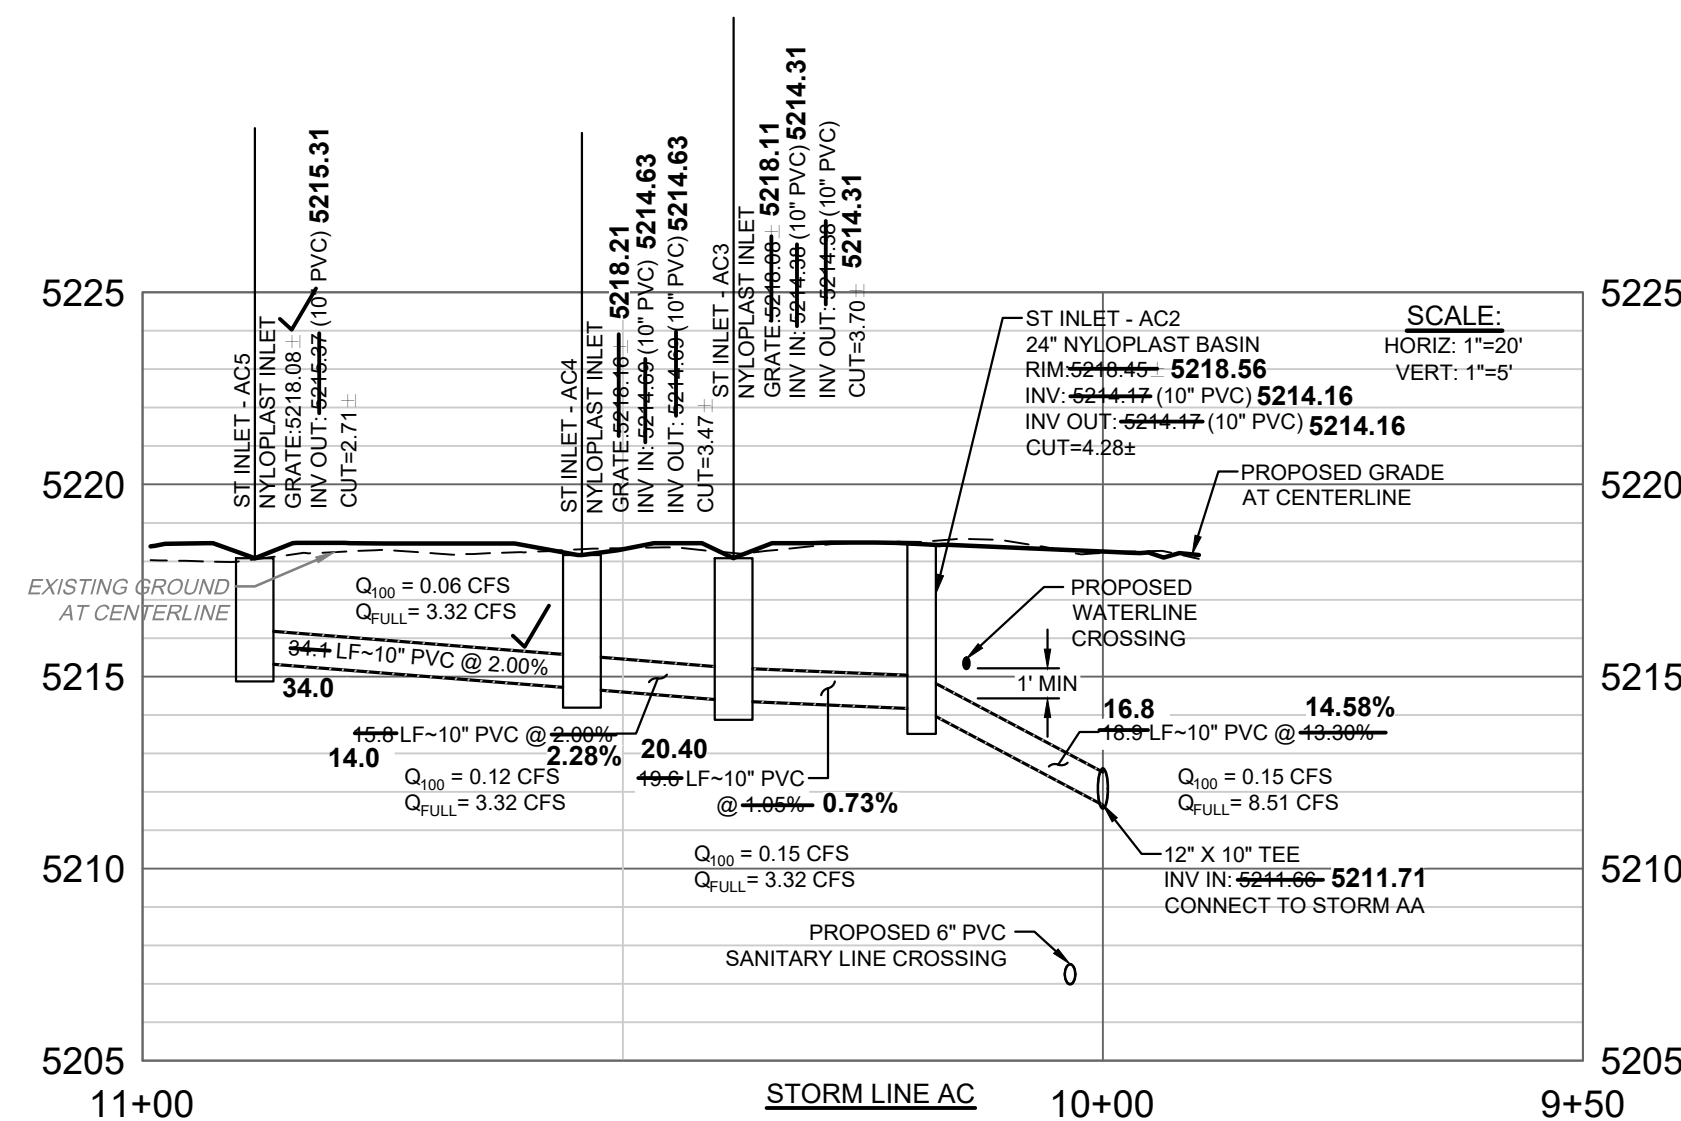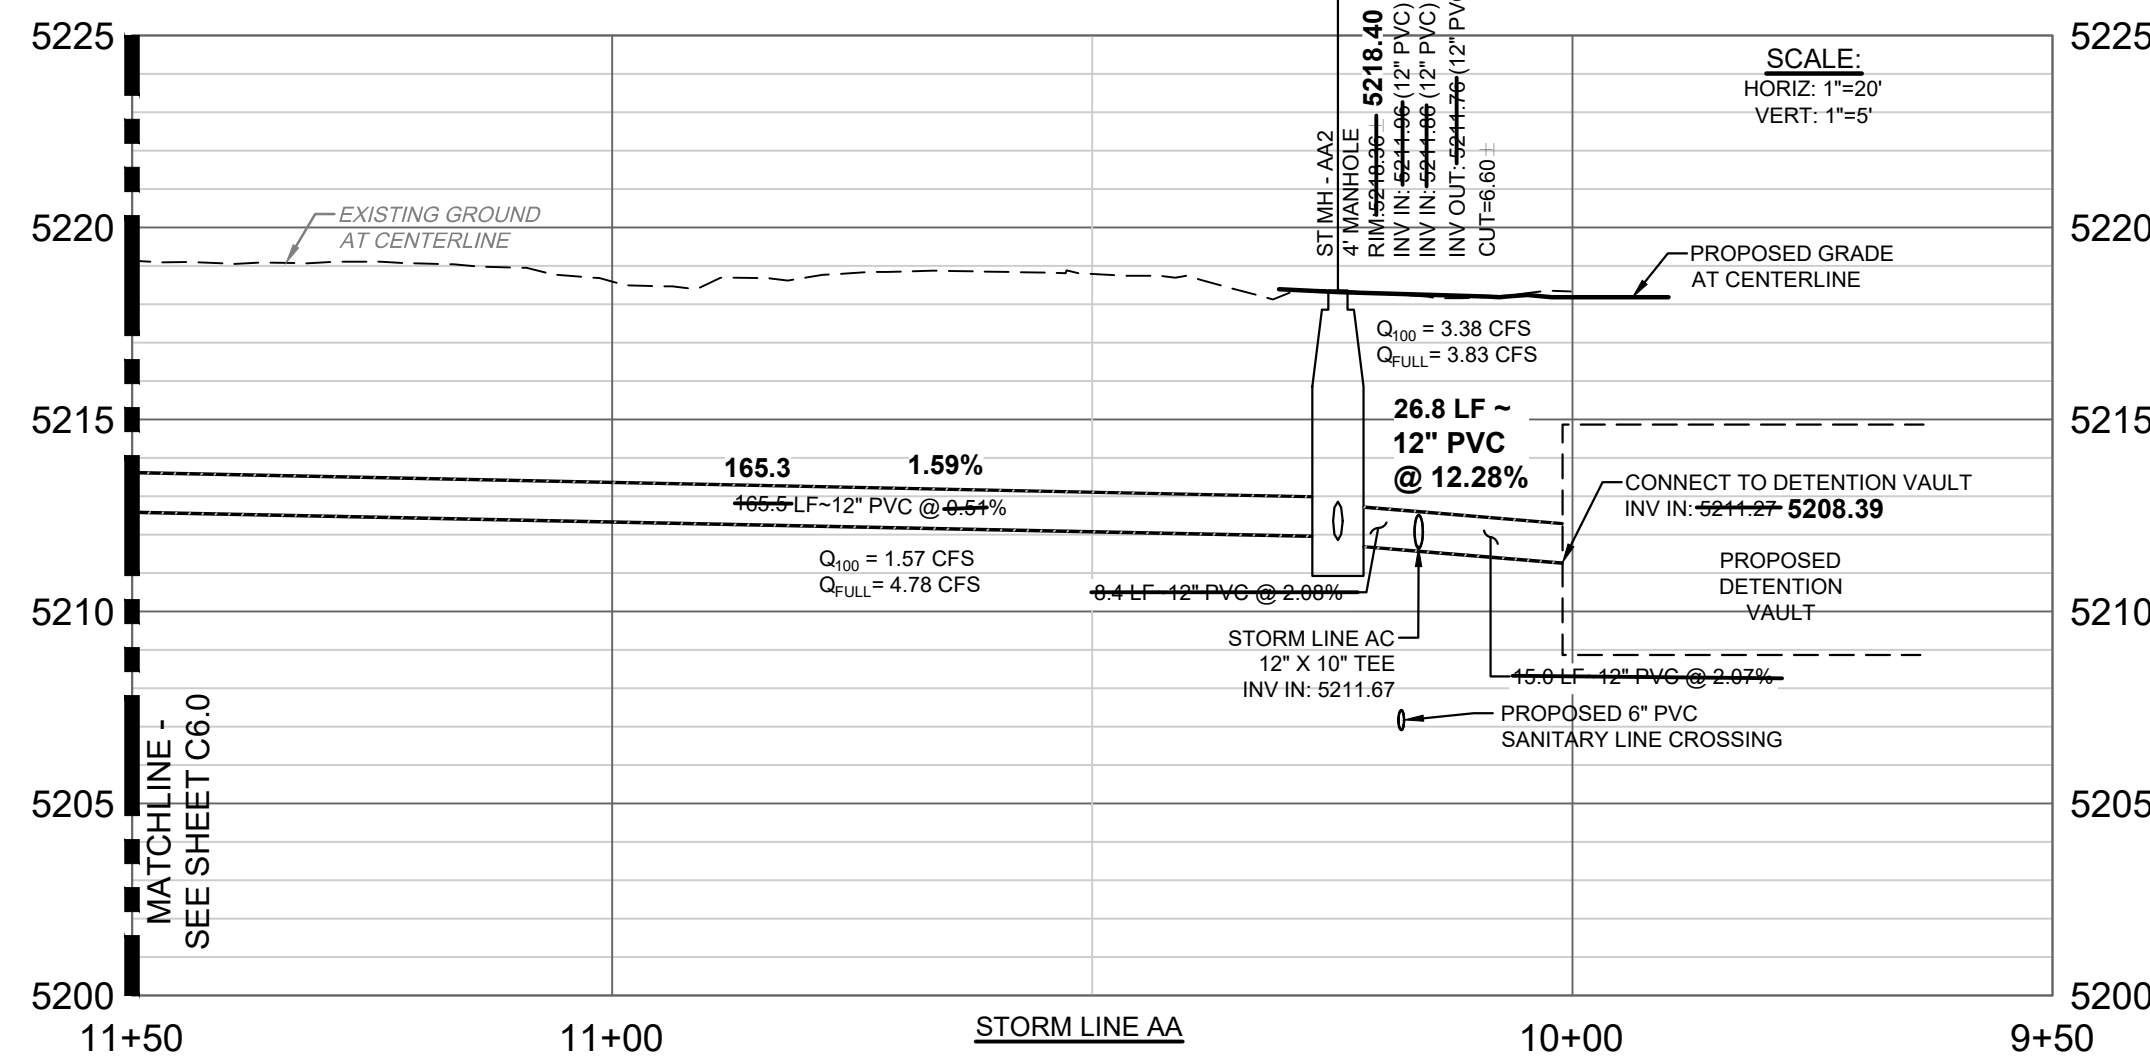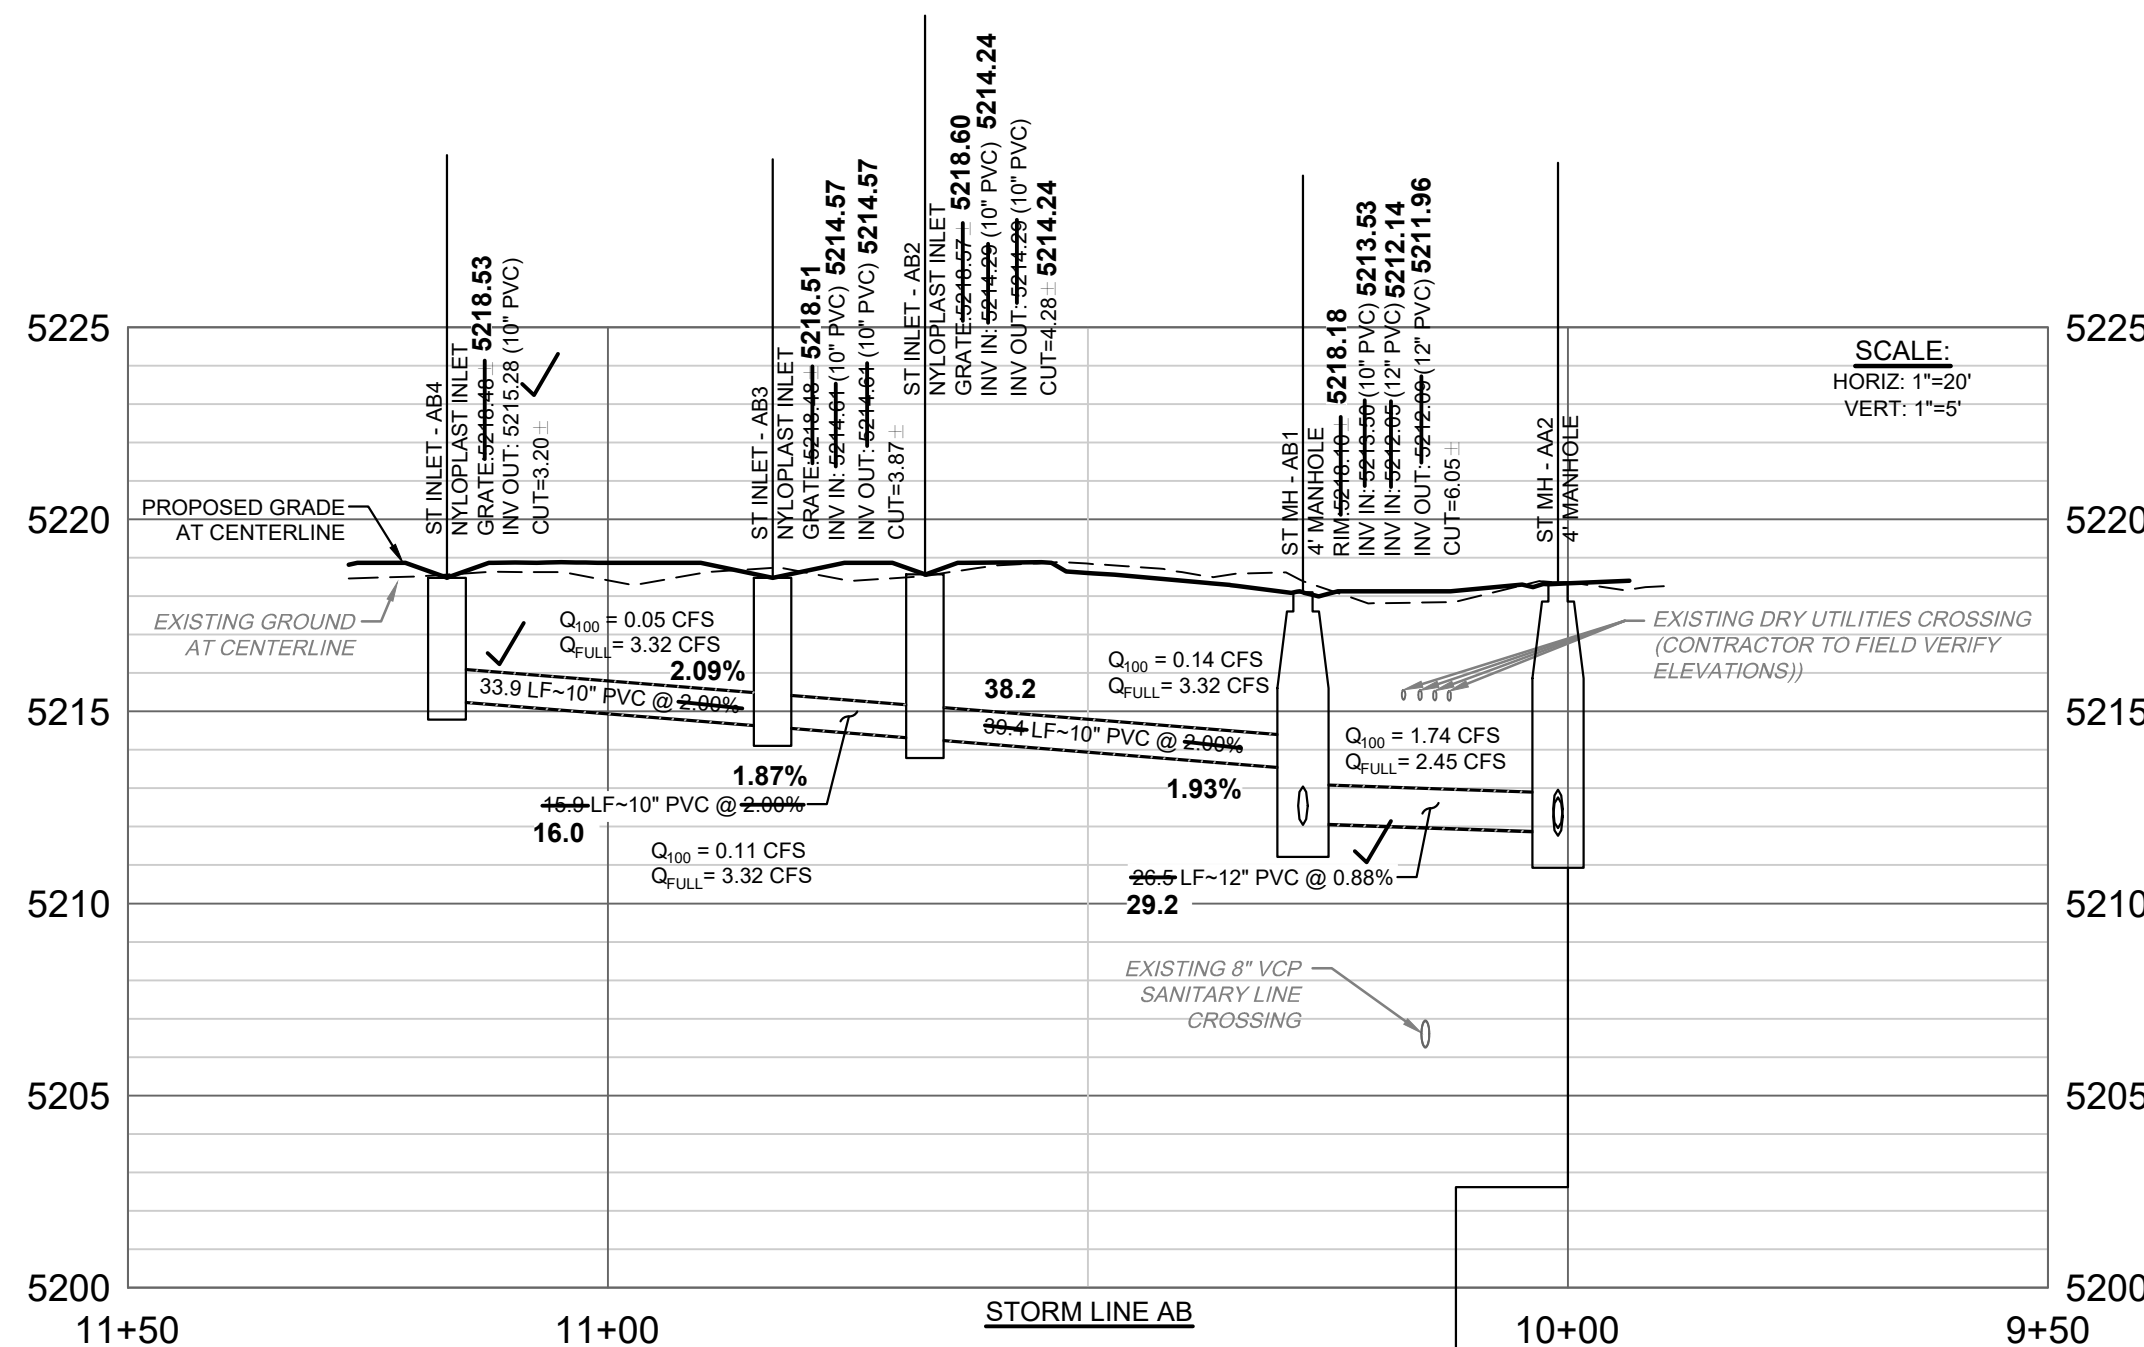


RECORD DRAWING

By: Ted Swan for and on behalf of Ware Malcomb
 Date: 12/11/2019
 Based on information provided by:
 Surveyor: Jeffrey J. Mackenna PLS: 34183
 Company: Falcon Surveying Inc.
 Date(s): 10/29/2019


This "drawing" is a record document prepared from and based upon, in part, information provided by others. Neither Ware Malcomb nor the Engineer of Record has verified the accuracy of this information and shall not be responsible for any errors or omissions which may be incorporated herein as a result.

ALL STORM PIPES, INLETS, AND MANHOLES ARE PRIVATE

DS PROJECT NO.		2017-PROJMSTR-0000589 / 2017-SSPR-0000099				
PROJECT NAME:		PLATTE VALLEY APARTMENTS - RENOVATION & ADDITIONS				
DESIGNED BY	BM	DATE	11/22/2017	DATE ISSUED	11/22/2017	DRAWING NO.
DRAWN BY	JP	DATE	11/22/2017			
CHECKED BY	TLS	DATE	11/22/2017	SHEET 8 OF 13		C6.1

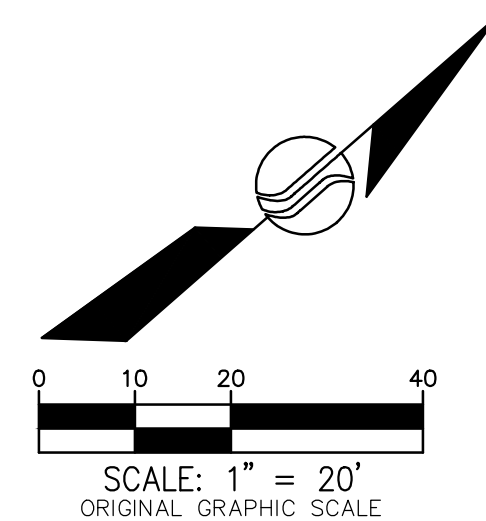

WARE MALCOMB assumes no responsibility for utility locations. The utilities shown on this drawing have been plotted from the best available information. It is, however, the contractors responsibility to field verify the location of all utilities prior to the commencement of any construction.

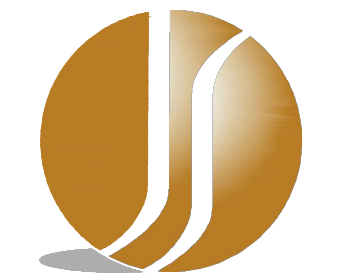

JANSEN STRAWN
 CONSULTING ENGINEERS
 A WARE MALCOMB Company

45 WEST 2ND AVENUE
 DENVER, CO 80223
 P.303.561.3333
 F.303.561.3339



Dec 11, 2019

FOR AND ON BEHALF OF
 JANSEN STRAWN CONSULTING ENGINEERS, INC.

BENCHMARK:

THE BENCHMARK IS A 2" CITY AND COUNTY OF DENVER BRASS CAP # 373 AR THE SOUTHEAST CORNER OF DOWNING STREET AND 28TH AVENUE AT THE TOP OF CURB, ELEVATION = 5229.23, NAVD

CALL UTILITY NOTIFICATION CENTER OF COLORADO
811
 CALL 2 BUSINESS DAYS IN ADVANCE BEFORE YOU DIG, GRADE OR EXCAVATE FOR THE MARKING OF UNDERGROUND MEMBER UTILITIES.

No.	Description of Revisions	Date	By
5	WASTEWATER REVISIONS	09/26/18	TLS
4	ADDENDUM # 4	08/02/18	TLS
3	CONSTRUCTION DOCUMENTS	06/27/18	TLS
2	CONSTRUCTION DOCUMENTS	11/01/17	TLS
1	90% CONSTRUCTION DOCUMENTS	10/06/17	TLS

Designed By: BSM
 Checked By: TLS




PLATTE VALLEY APARTMENTS
 RENOVATION & ADDITIONS

STORM PLAN & PROFILE

Date: 08/02/2018
 Job No.: 16090
 Sheet:

C6.1


Sheet of

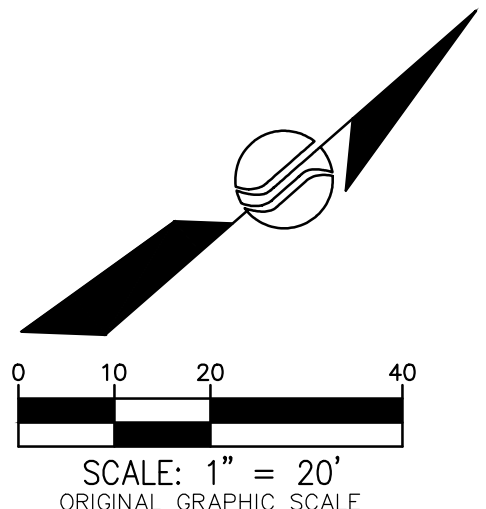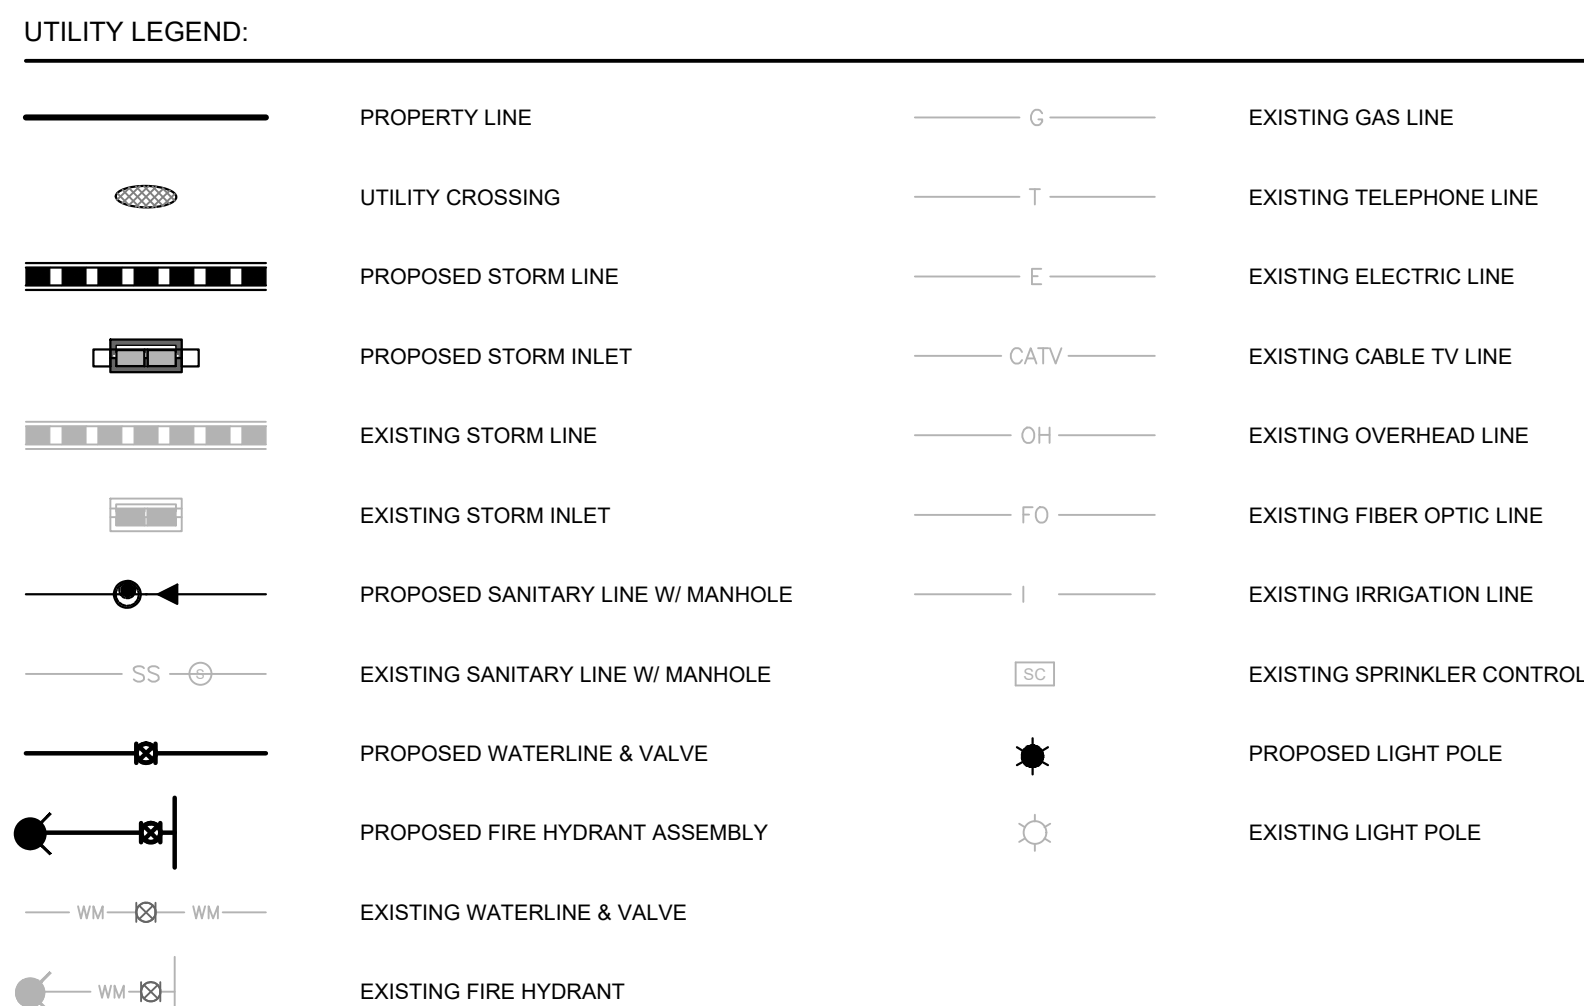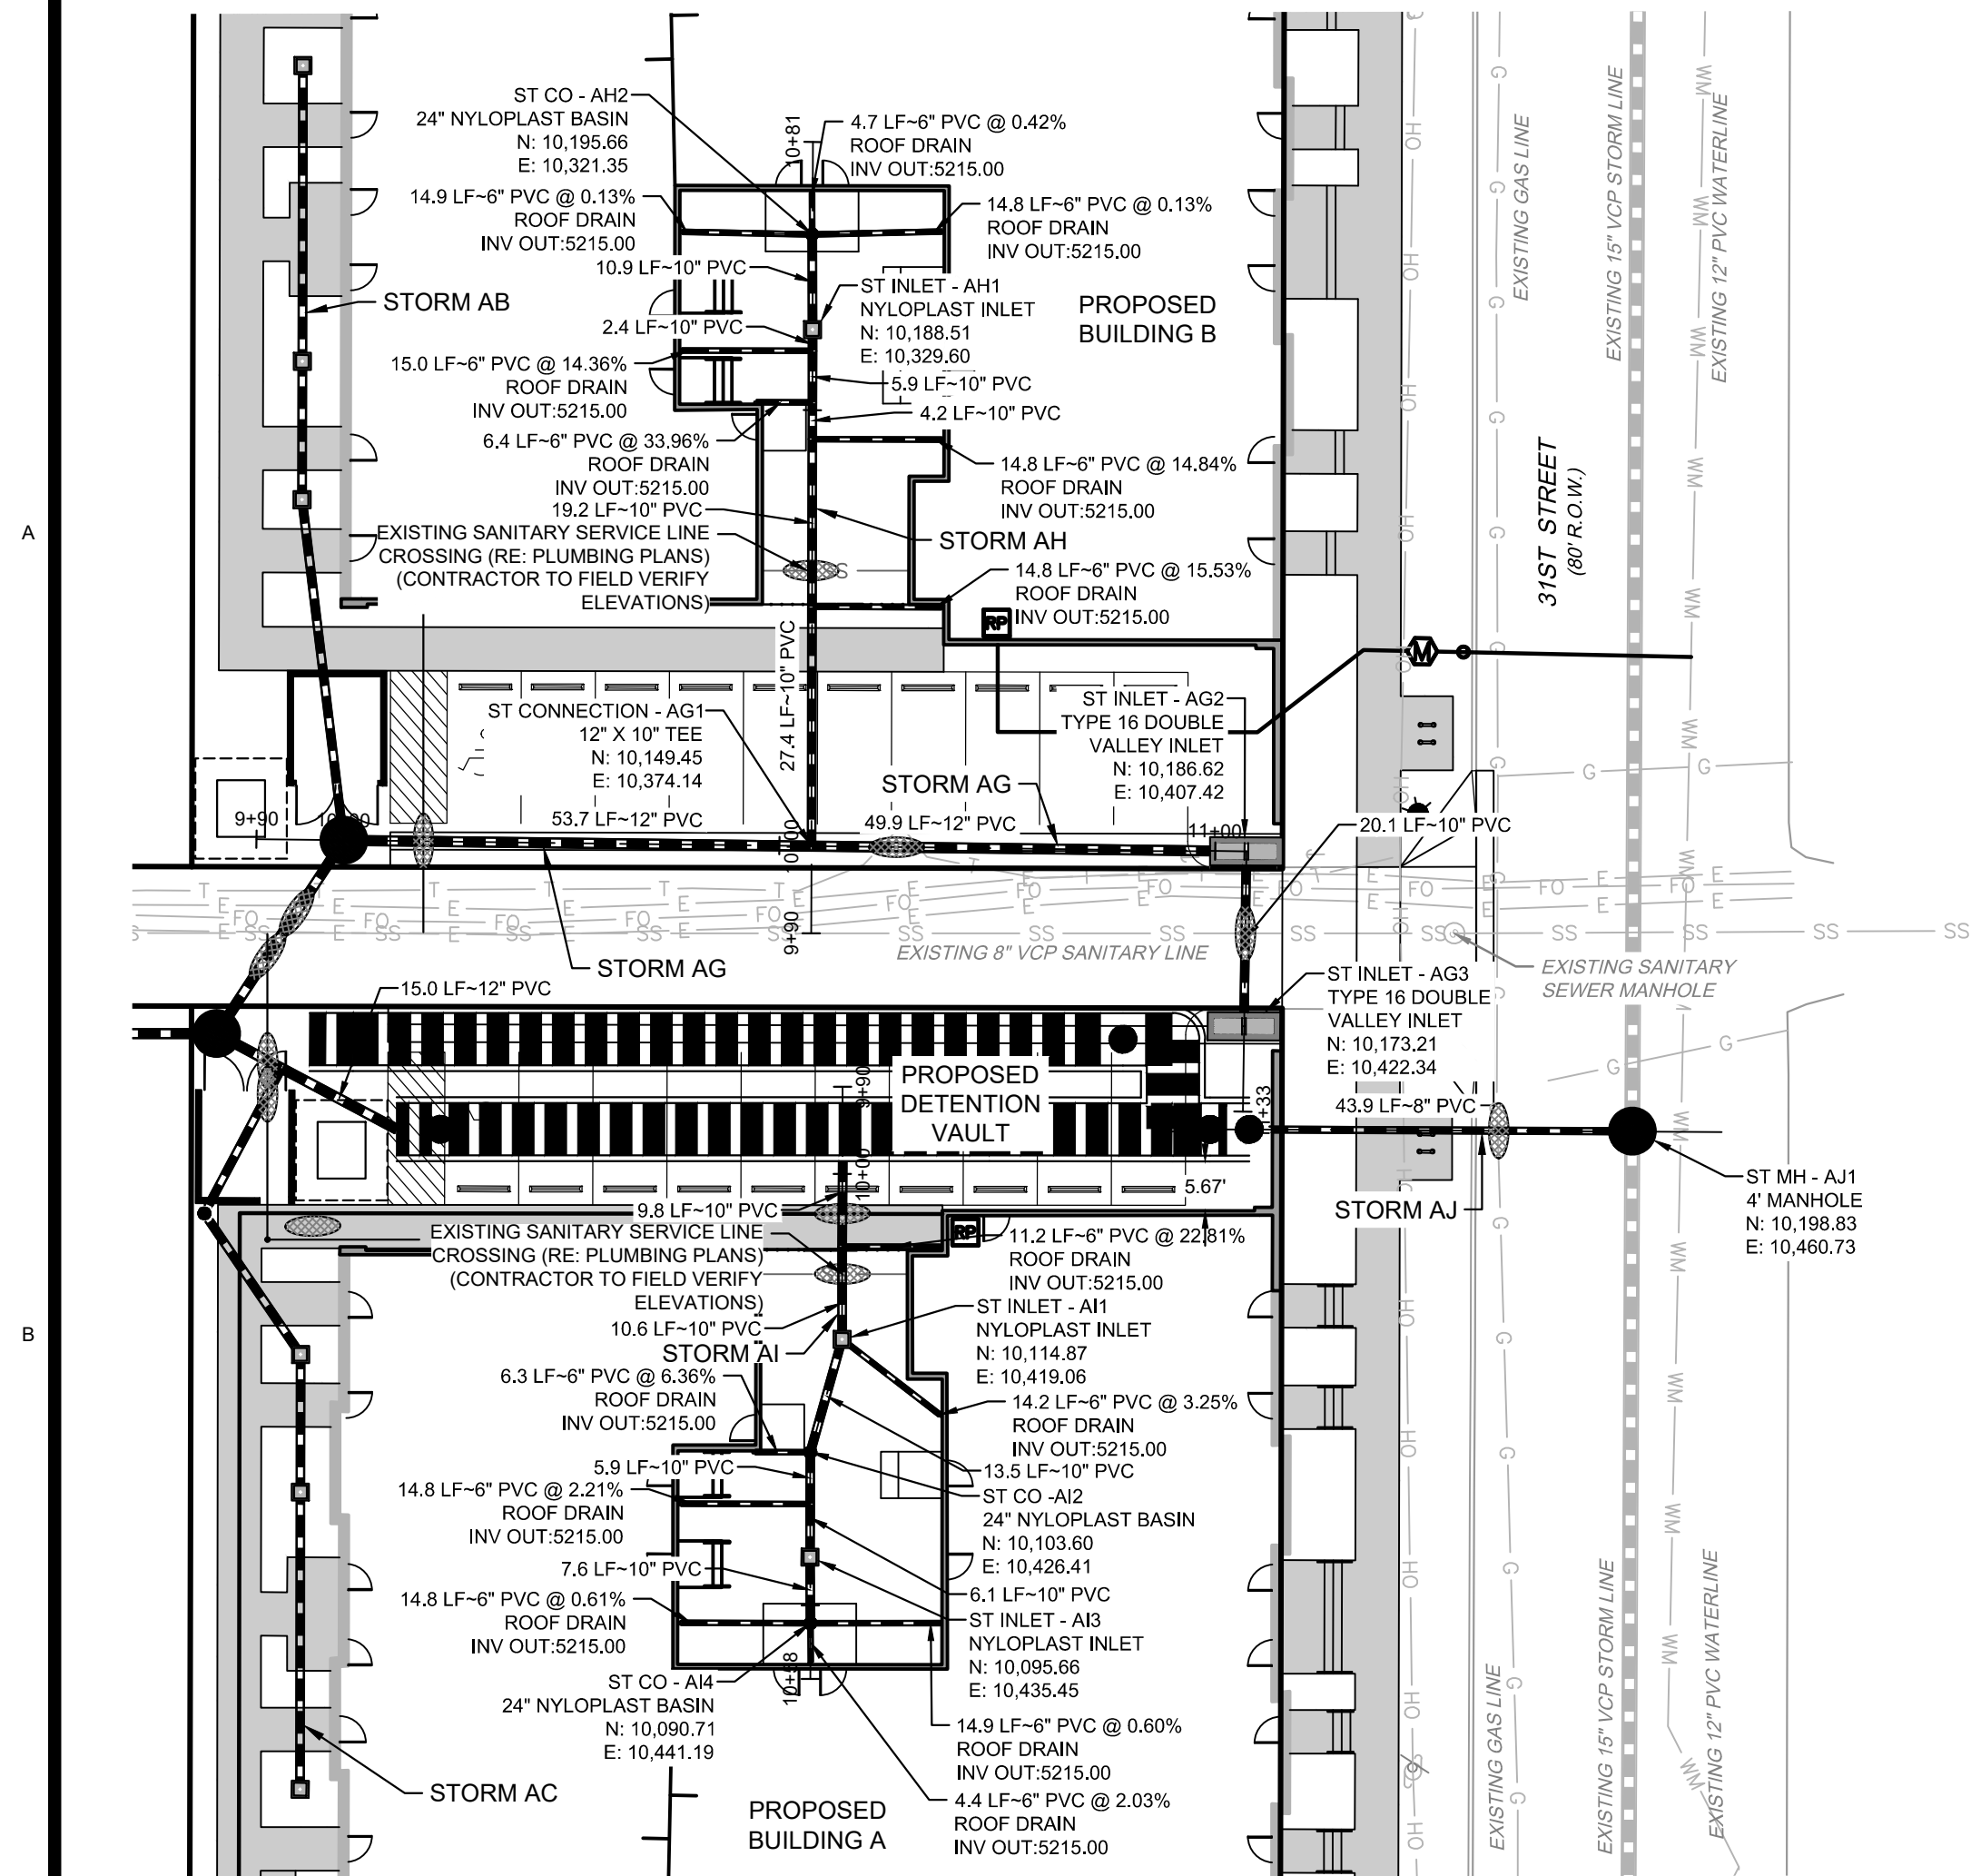

WARE MALCOMB assumes no responsibility for utility locations. The utilities shown on this drawing have been plotted from the best available information. It is, however, the contractors responsibility to field verify the location of all utilities prior to the commencement of any construction.

NOTES:

- 1) THE CONTRACTOR IS TO VERIFY THE ELEVATION OF ALL EXISTING UTILITIES WHERE NEW WORK WILL CONNECT AND NOTIFY THE ENGINEER IF THERE ARE ANY DISCREPANCIES.
- 2) INLETS ARE CONTROLLED AT CENTER OF BOX AT FLOWLINE.
- 3) MANHOLES ARE CONTROLLED AT CENTER OF MANHOLE.
- 4) ALL STORM LINES TO BE CLASS III REINFORCED CONCRETE UNLESS OTHERWISE NOTED.

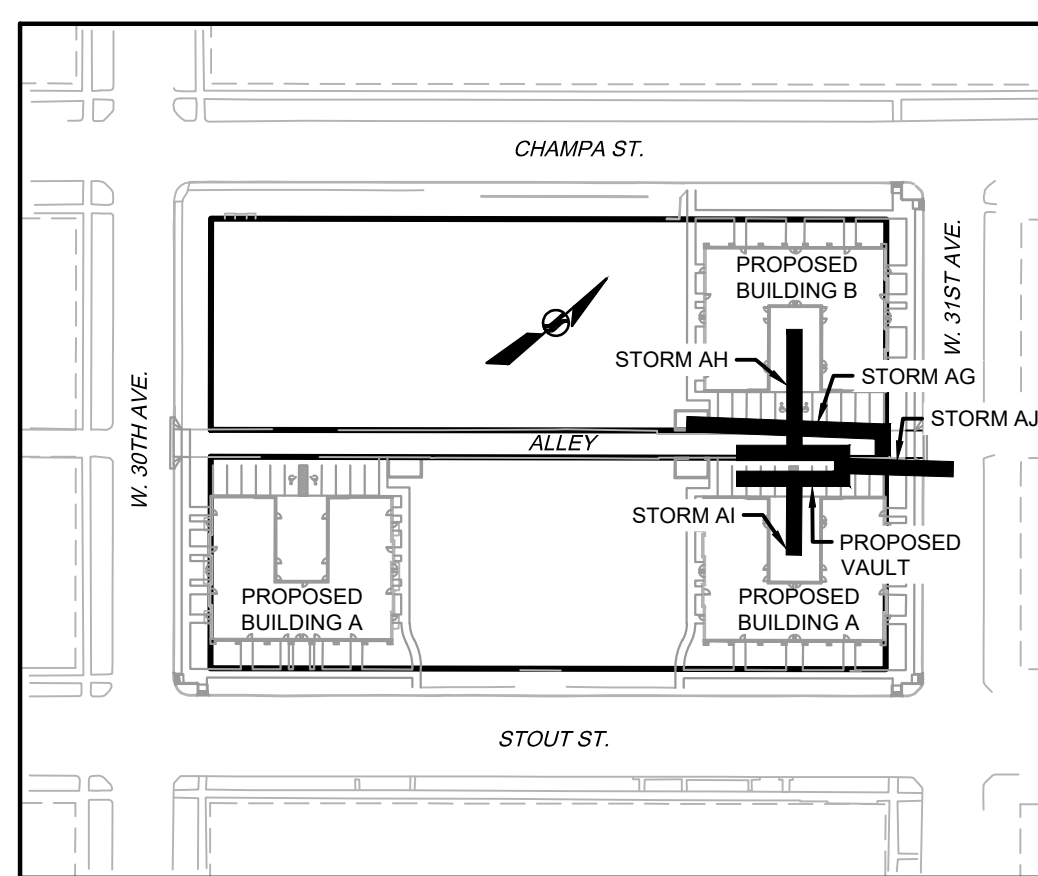

JANSEN STRAWN
CONSULTING ENGINEERS
A WARE MALCOMB Company

45 WEST 2ND AVENUE
DENVER, CO 80223
P.303.561.3333
F.303.561.3339

COLORADO LICENSED PROFESSIONAL ENGINEER
43963
Dec 11, 2019
FOR AND ON BEHALF OF
JANSEN STRAWN CONSULTING ENGINEERS, INC.

BENCHMARK:

THE BENCHMARK IS A 2" CITY AND COUNTY OF DENVER BRASS CAP # 373 AR THE SOUTHEAST CORNER OF DOWNING STREET AND 28TH AVENUE AT THE TOP OF CURB, NAVD
ELEVATION = 5229.23, NAVD

CALL UTILITY NOTIFICATION CENTER OF COLORADO
811
CALL 2 BUSINESS DAYS IN ADVANCE BEFORE YOU DIG, GRADE OR EXCAVATE FOR THE MARKING OF UNDERGROUND MEMBER UTILITIES.

No.	Description of Revisions	Date	By	Checked By: TLS
5	WASTEWATER REVISIONS	09/26/18	TLS	
4	ADDENDUM # 4	06/02/18	TLS	
3	CONSTRUCTION DOCUMENTS	06/27/18	TLS	
2	CONSTRUCTION DOCUMENTS	11/01/17	TLS	
1	90% CONSTRUCTION DOCUMENTS	10/06/17	TLS	

Designed By: BSM

**PLATTE VALLEY APARTMENTS
RENOVATION & ADDITIONS**

STORM PLAN & PROFILE

Date: 08/02/2018
Job No.: 16090
Sheet: **C6.2**





Sheet of

ALL STORM PIPES, INLETS, AND MANHOLES ARE PRIVATE (EXCEPT NEW MANHOLE CONNECTION TO PUBLIC MAIN IN 31ST ST.)


RECORD DRAWING

By: Ted Swan for and on behalf of Ware Malcomb
Date: 12/11/2019
Based on information provided by:
Surveyor: Jeffrey J. Mackenna PLS: 34183
Company: Falcon Surveying Inc.
Date(s): 10/29/2019

This "drawing" is a record document prepared from and based upon, in part, information provided by others. Neither Ware Malcomb nor the Engineer of Record has verified the accuracy of this information and shall not be responsible for any errors or omissions which may be incorporated herein as a result.

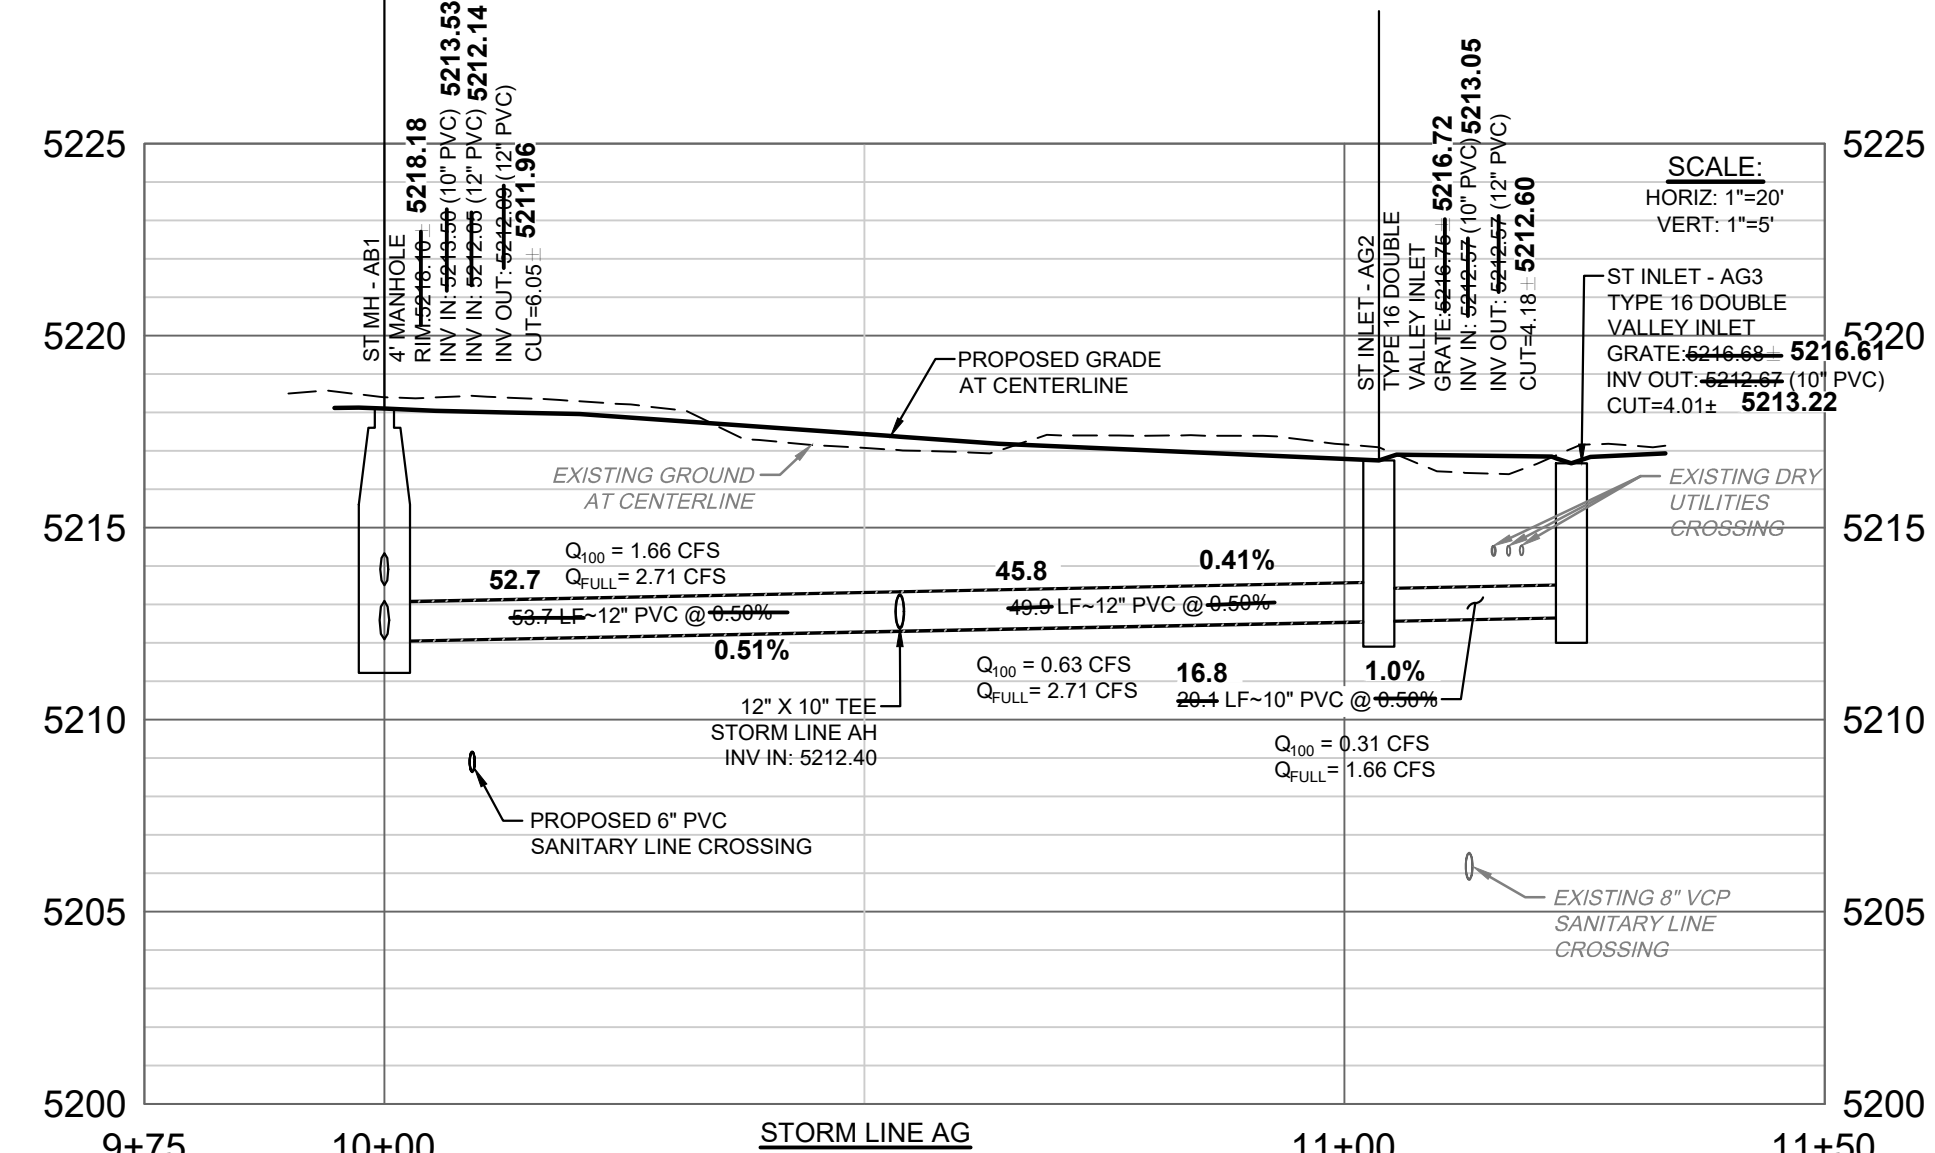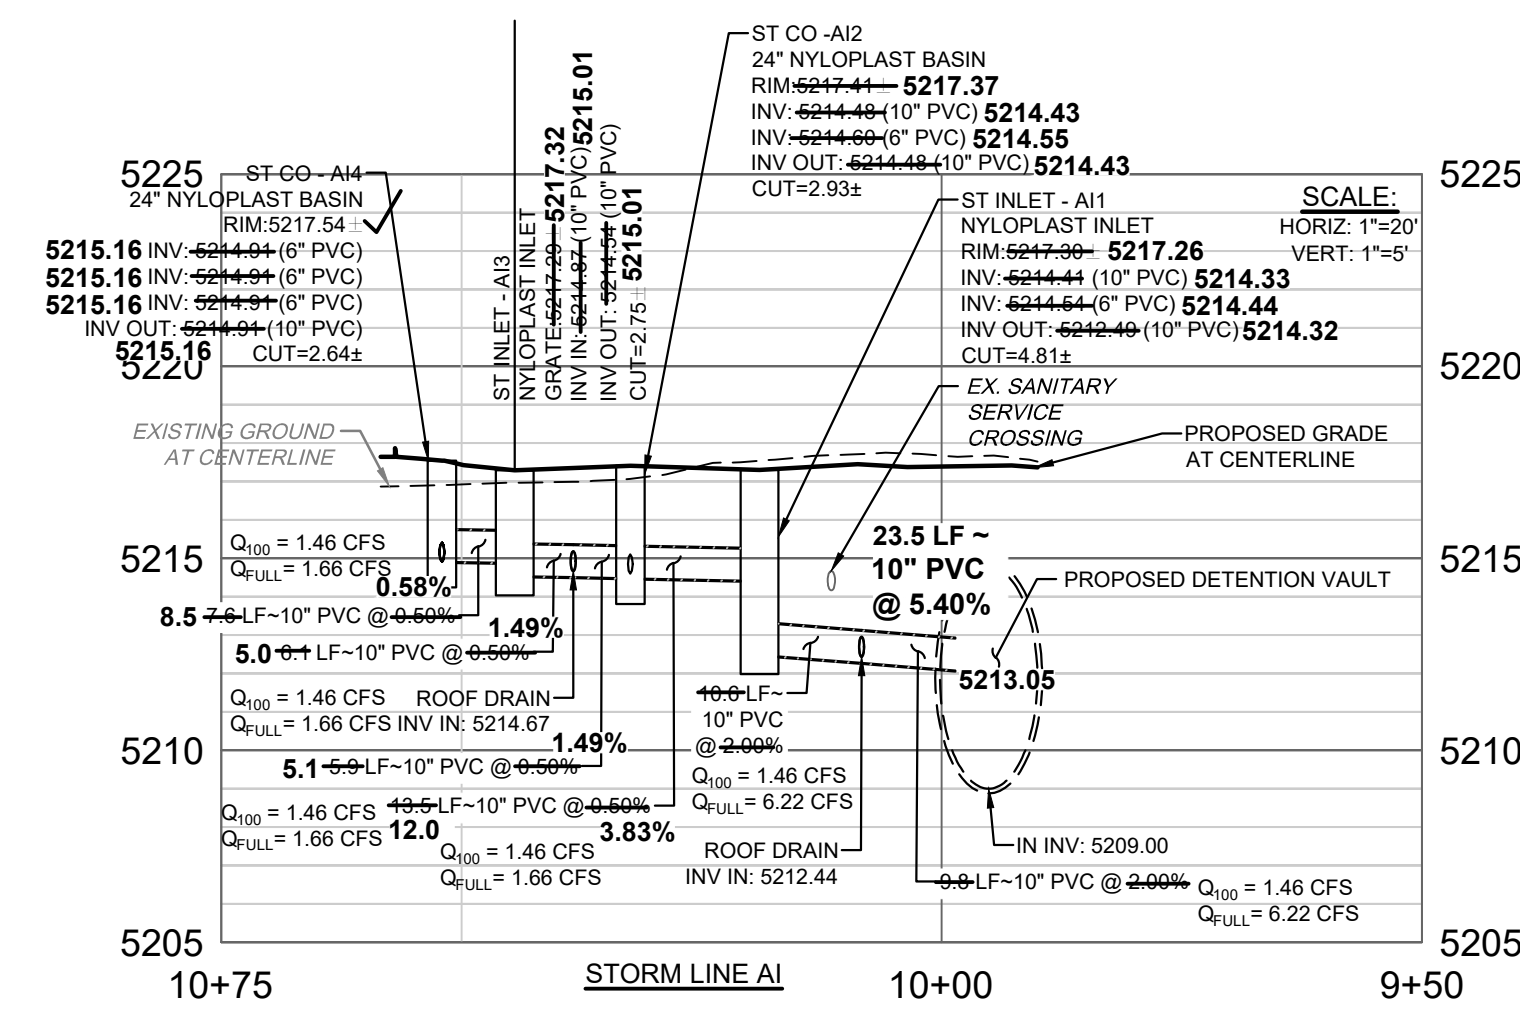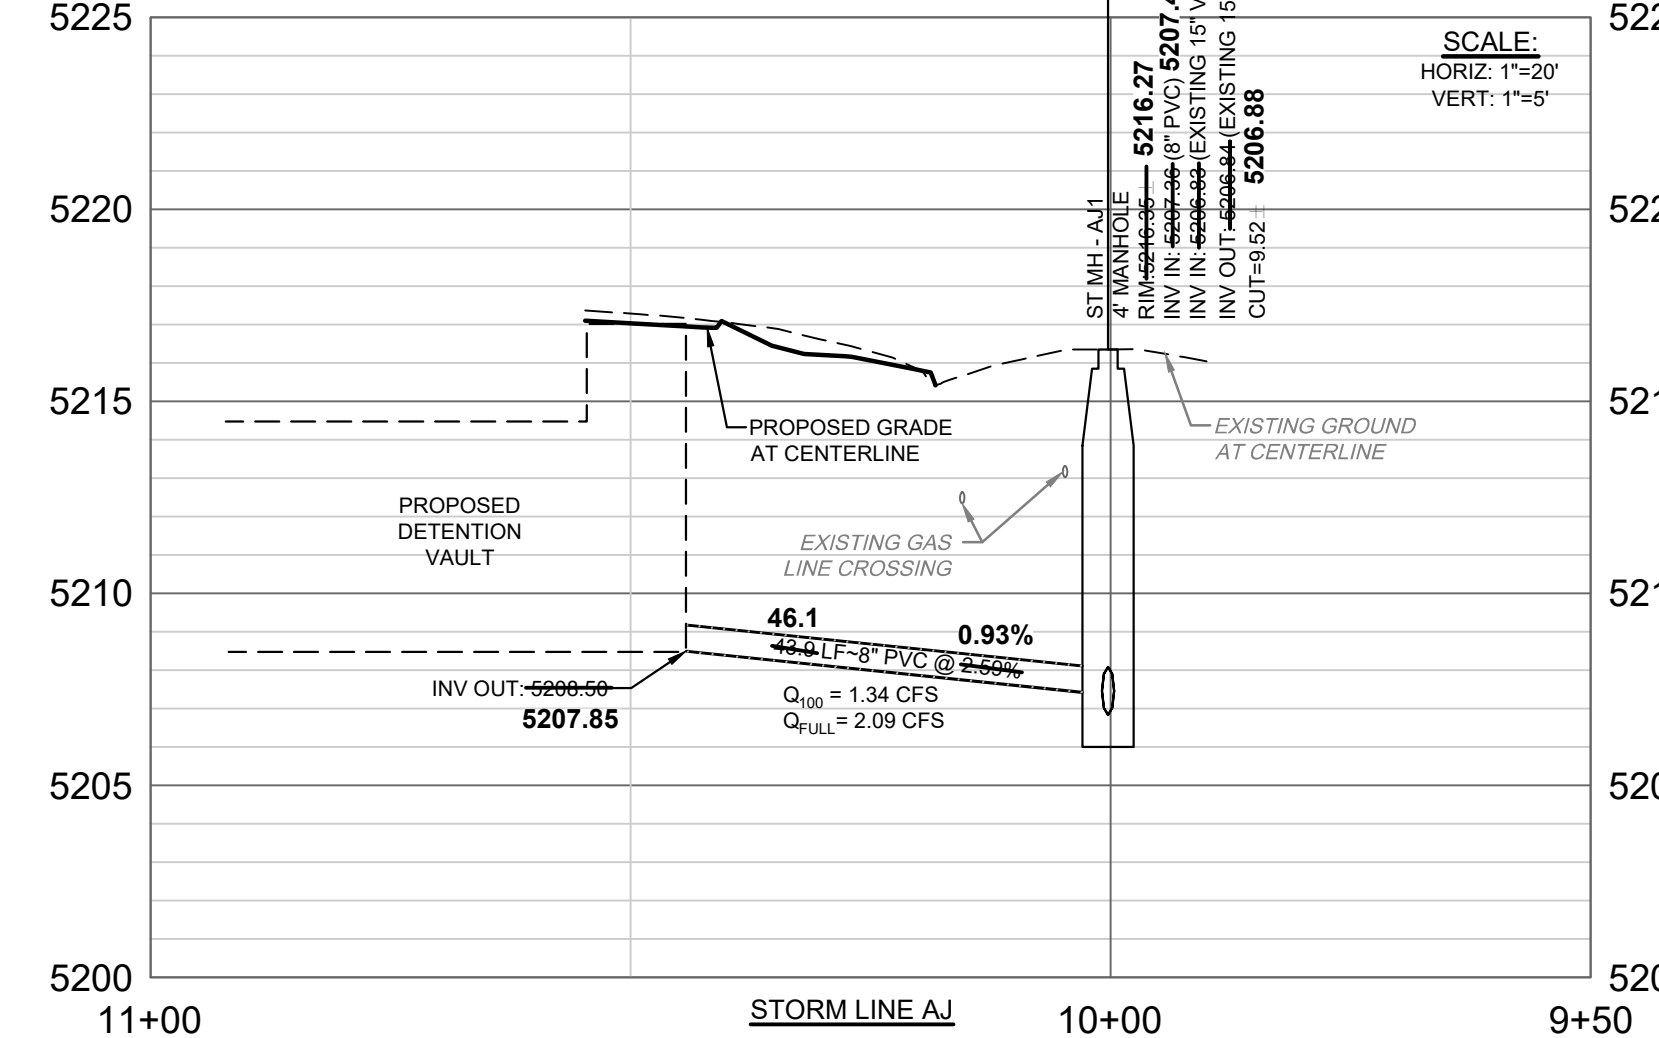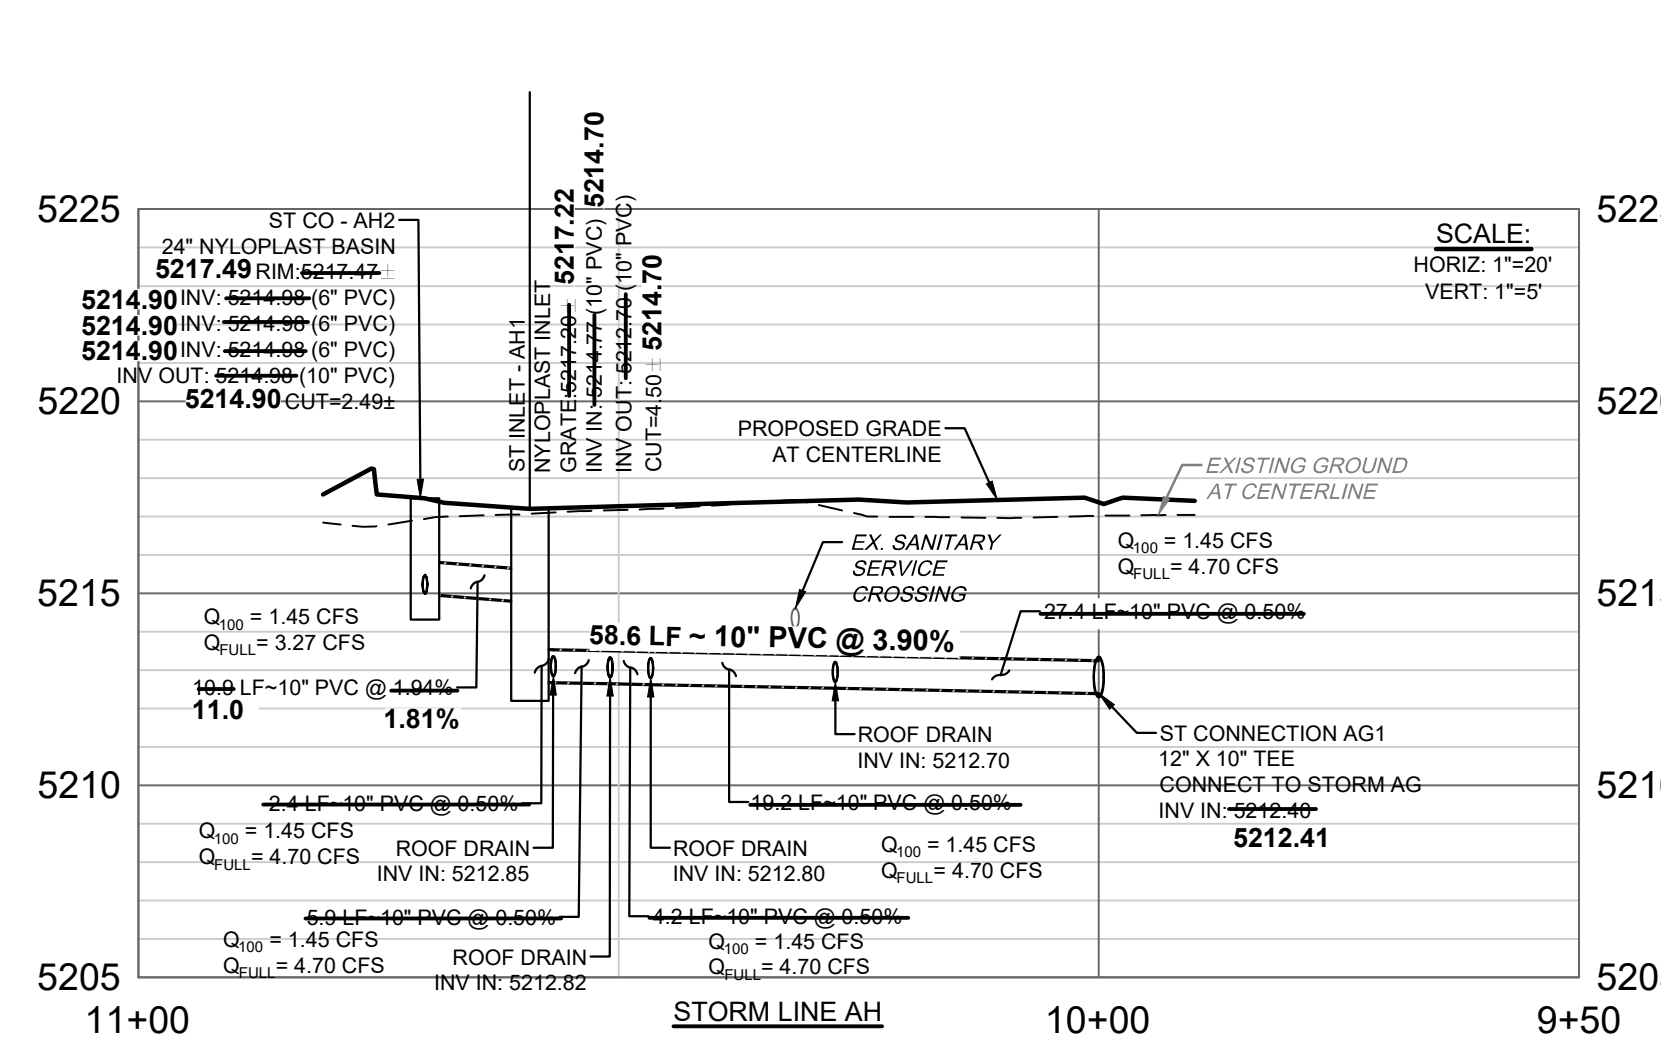

DS PROJECT NO.	2017-PROJUMSTR-0000589 / 2017-SSPR-0000099					
PROJECT NAME:	PLATTE VALLEY APARTMENTS - RENOVATION & ADDITIONS					
DESIGNED BY	EBM	DATE	11/22/2017	DATE ISSUED	11/22/2017	DRAWING NO.
DRAWN BY	JP	DATE	11/22/2017	SHEET 9 OF 13		C6.2
CHECKED BY	TLS	DATE	11/22/2017			

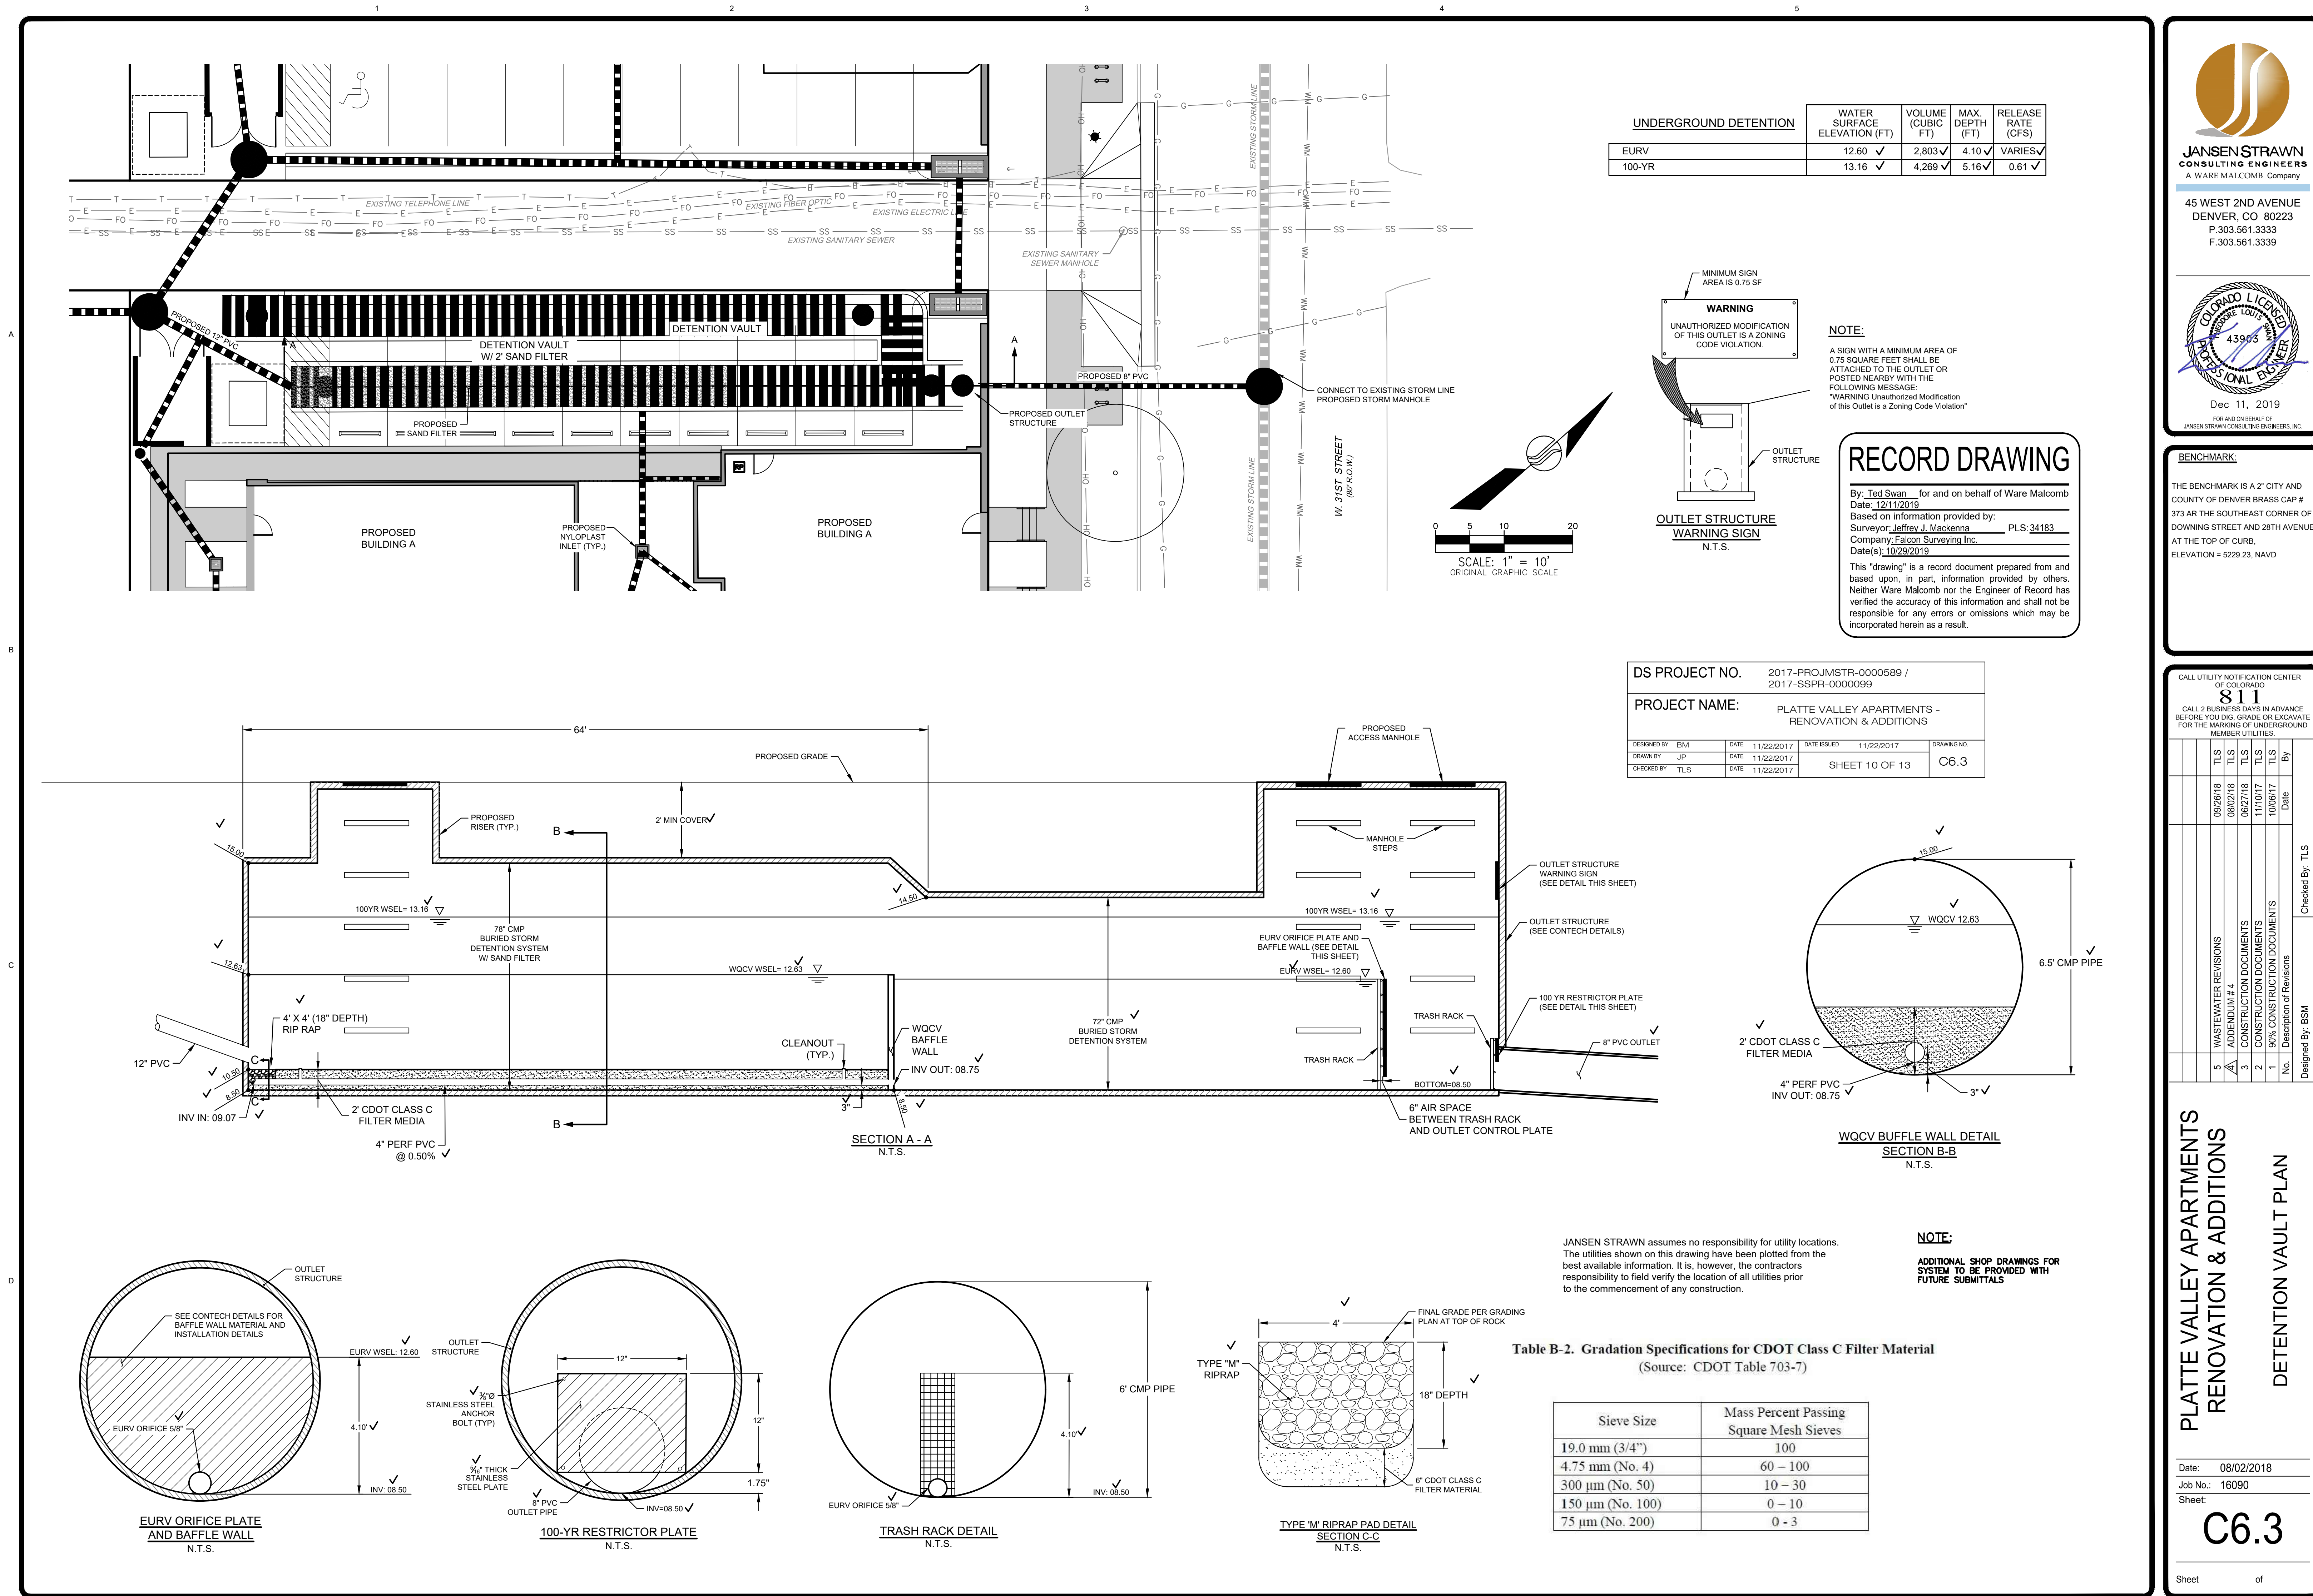

JANSEN STRAWN
CONSULTING ENGINEERS
A WARE MALCOMB Company

45 WEST 2ND AVENUE
DENVER, CO 80223
P.303.561.3333
F.303.561.3339



Dec 11, 2019
FOR AND ON BEHALF OF
JANSEN STRAWN CONSULTING ENGINEERS, INC.

BENCHMARK:

THE BENCHMARK IS A 2" CITY AND COUNTY OF DENVER BRASS CAP # 373 AR THE SOUTHEAST CORNER OF DOWNING STREET AND 28TH AVENUE AT THE TOP OF CURB, ELEVATION = 5229.23, NAVD

CALL UTILITY NOTIFICATION CENTER OF COLORADO
811
CALL 2 BUSINESS DAYS IN ADVANCE BEFORE YOU DIG, GRADE OR EXCAVATE FOR THE MARKING OF UNDERGROUND MEMBER UTILITIES.

No.	Description of Revisions	Date	By
1	90% CONSTRUCTION DOCUMENTS	11/01/17	TLS
2	CONSTRUCTION DOCUMENTS	06/27/18	TLS
3	CONSTRUCTION DOCUMENTS	06/27/18	TLS
4	ADDENDUM #4	08/02/18	TLS
5	WASTEWATER REVISIONS	09/26/18	TLS

Designed By: BSM
Checked By: TLS

PLATTE VALLEY APARTMENTS
RENOVATION & ADDITIONS
DETENTION VAULT PLAN

Date: 08/02/2018
Job No.: 16090
Sheet:

C6.3

Sheet of



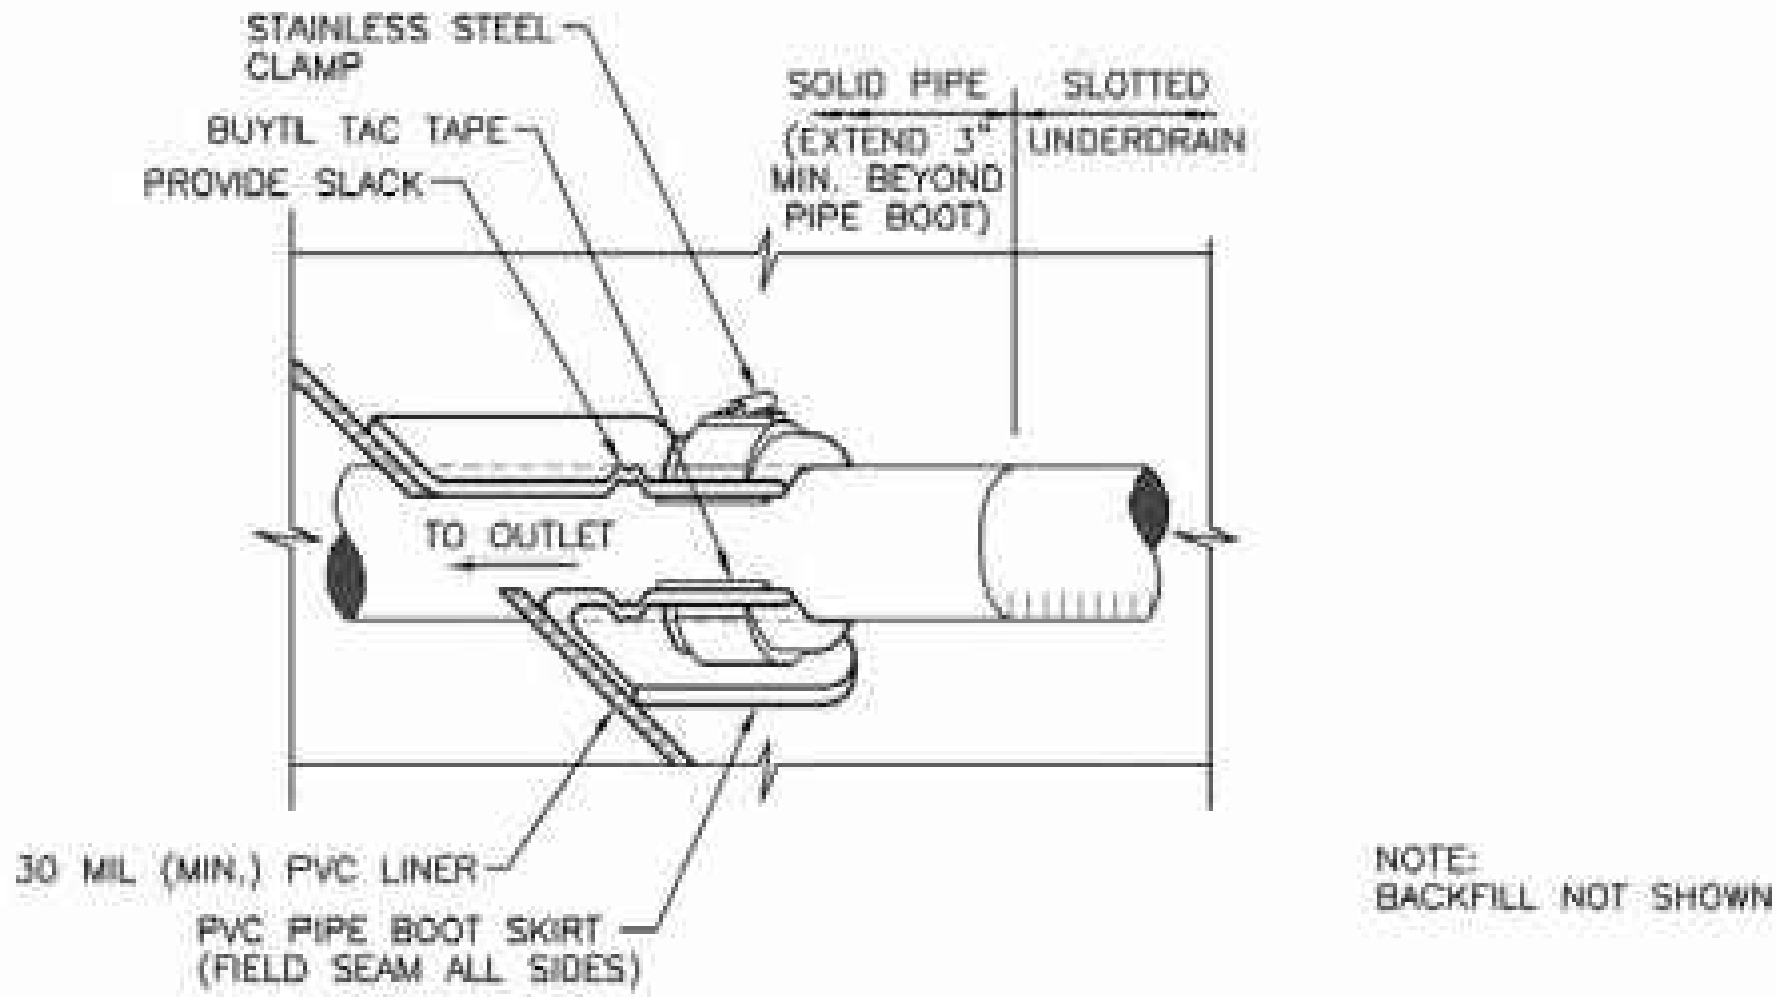


Figure SF-2. Geomembrane Liner/Underdrain Penetration Detail

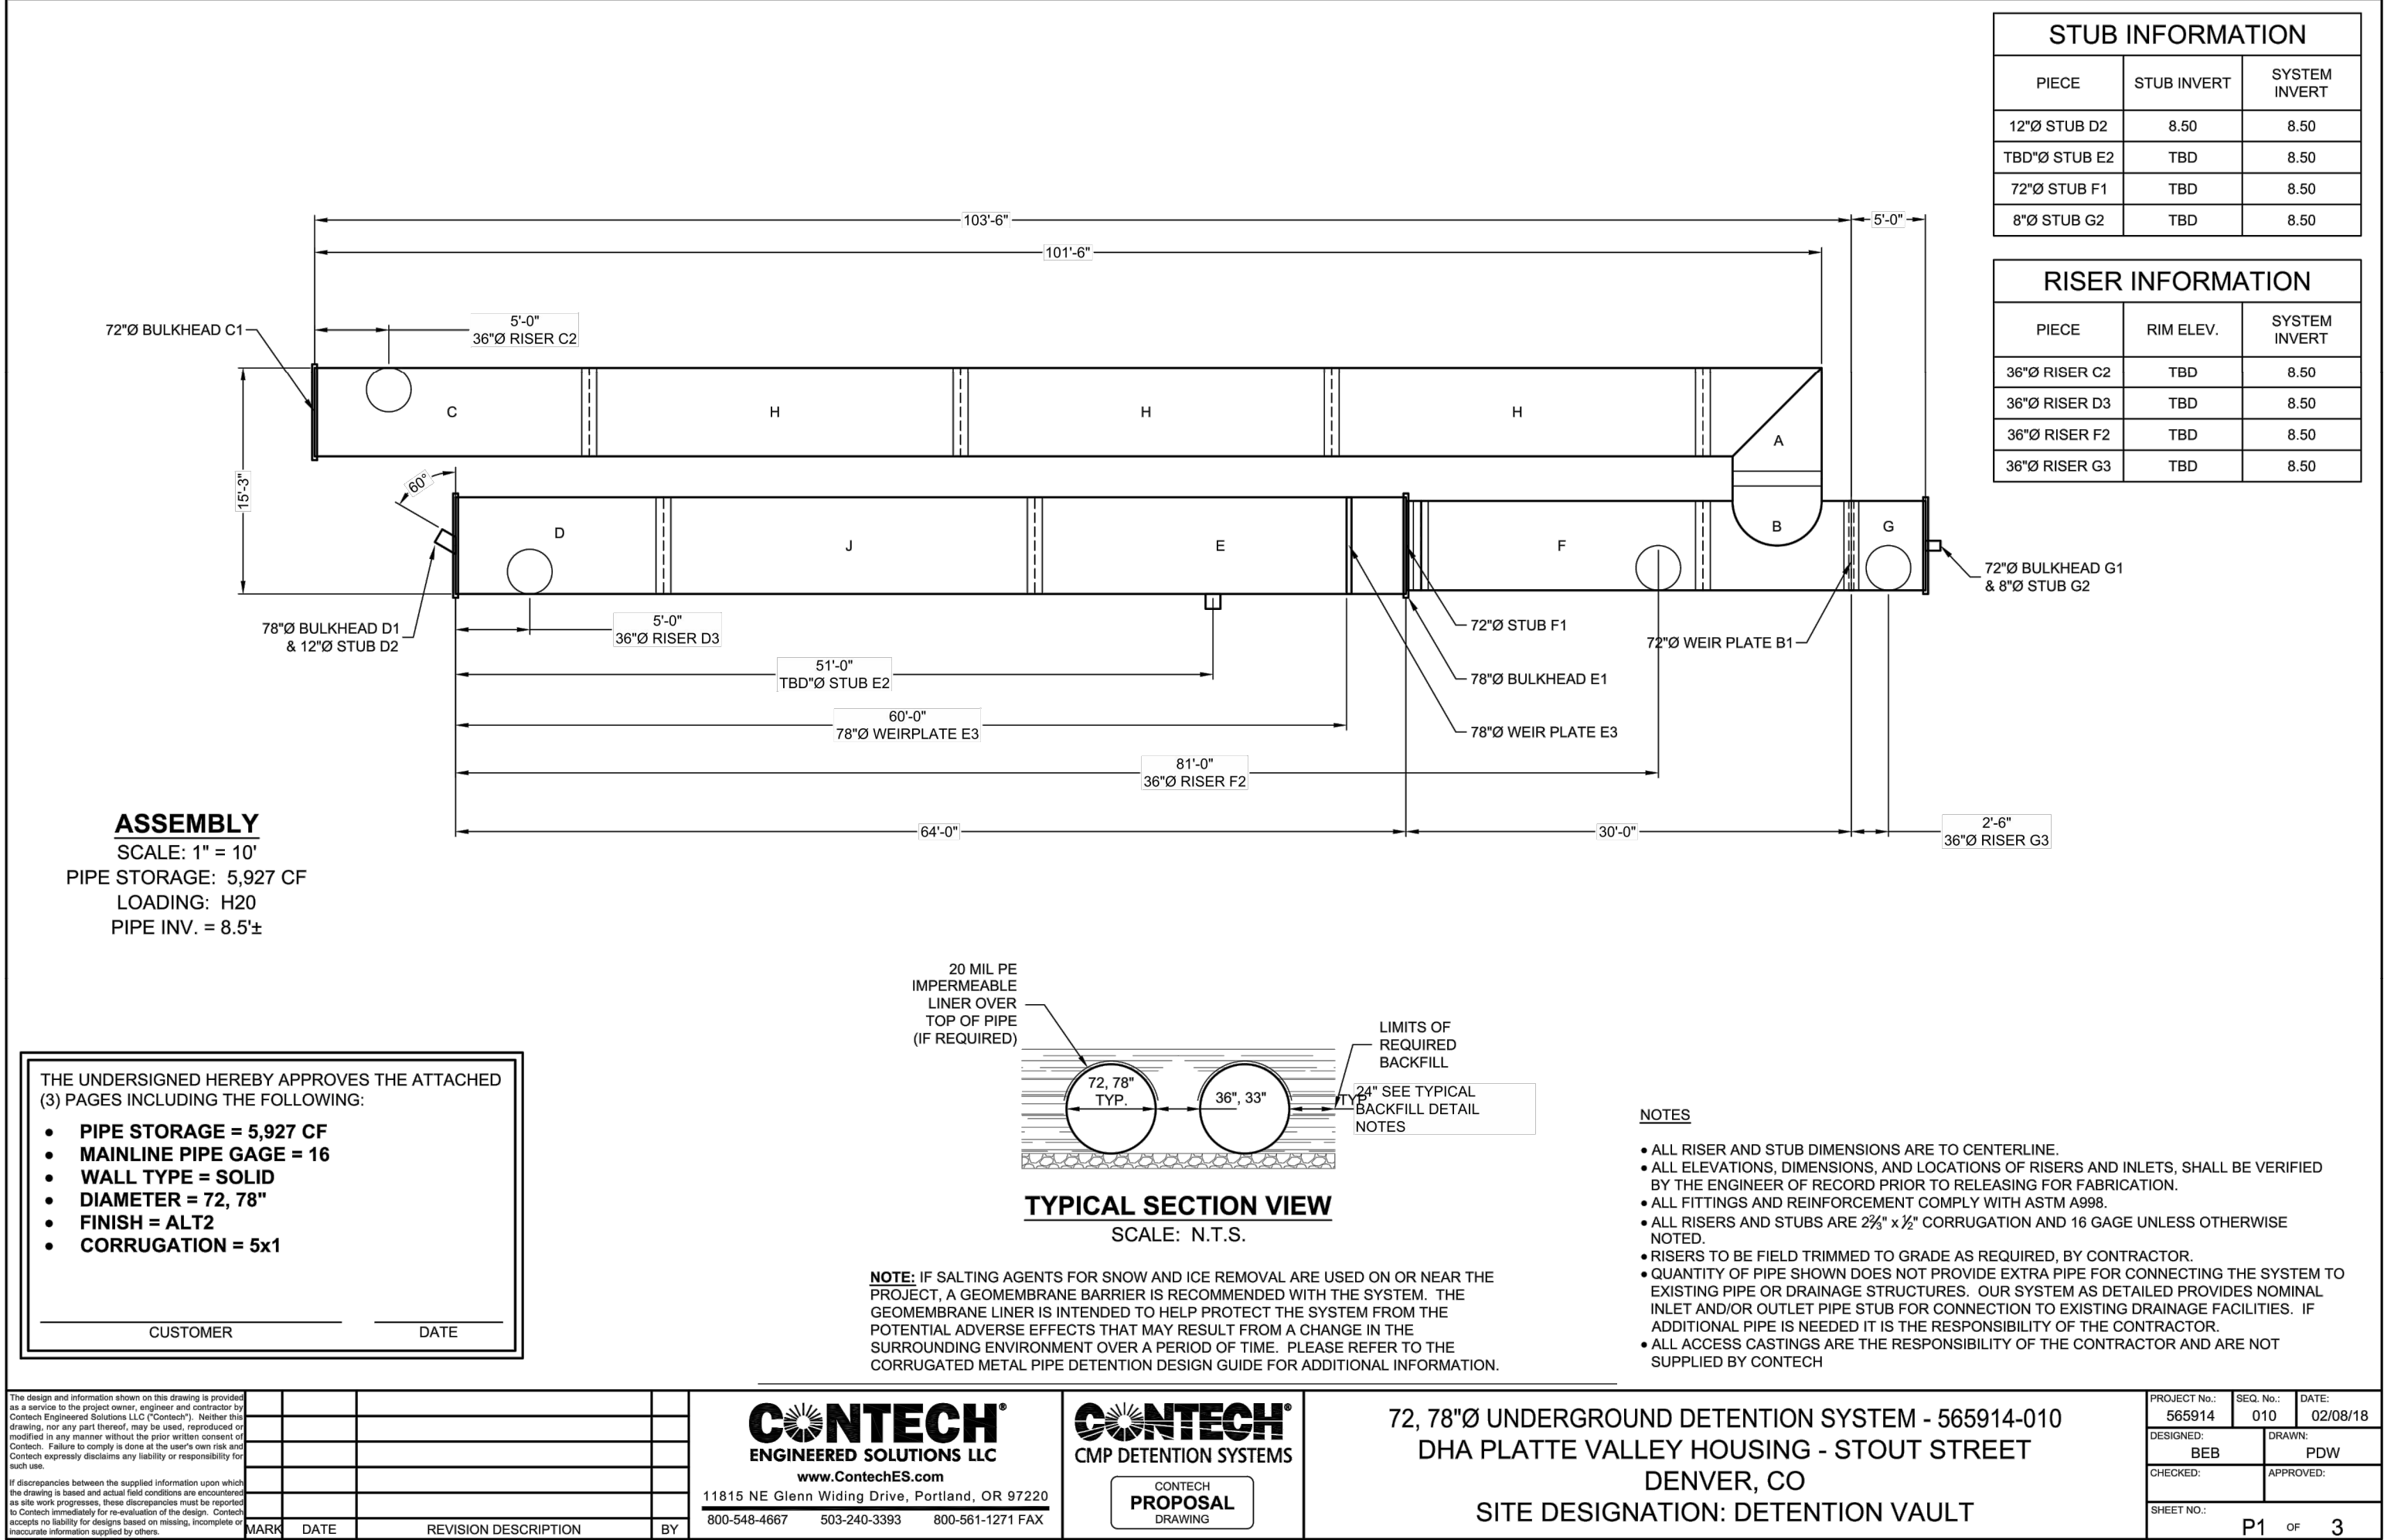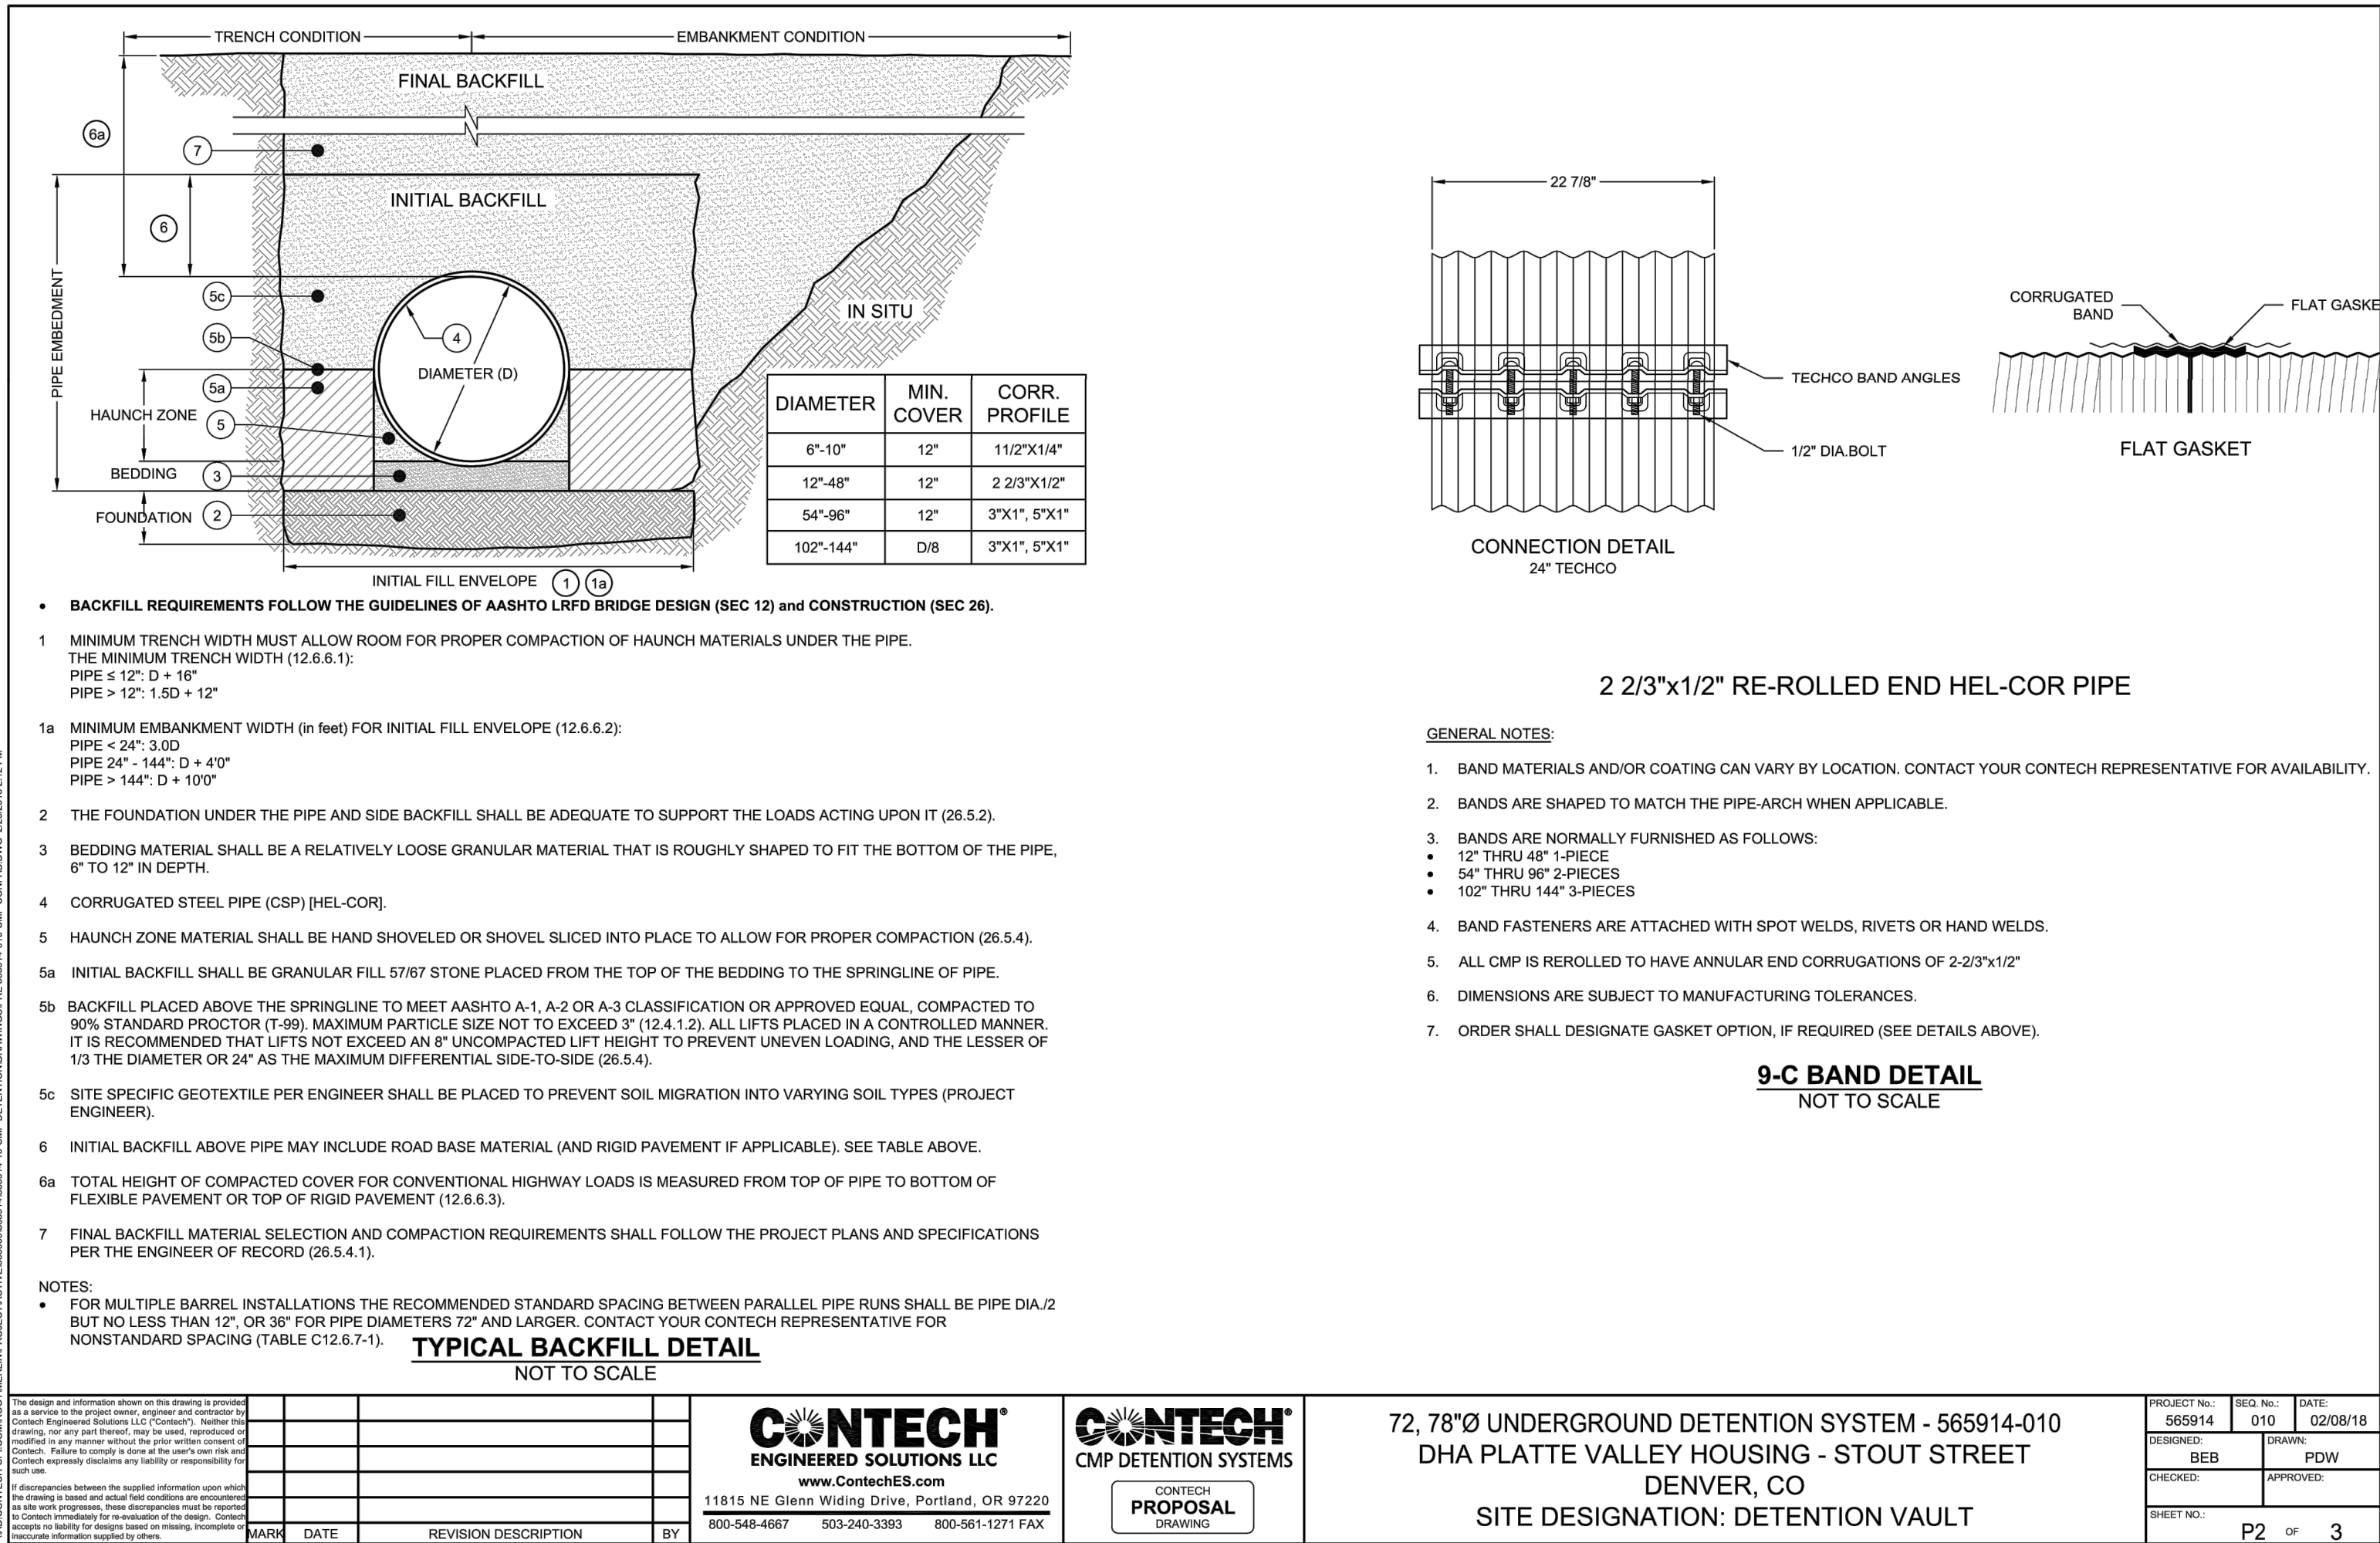

JANSEN STRAWN
CONSULTING ENGINEERS
A WARE MALCOMB Company

45 WEST 2ND AVENUE
DENVER, CO 80223
P.303.561.3333
F.303.561.3339

COLORED LICENSE
439963
JANSEN STRAWN CONSULTING ENGINEERS INC.

Dec 11, 2019

BENCHMARK:

THE BENCHMARK IS A 2" CITY AND COUNTY OF DENVER BRASS CAP # 373 AR THE SOUTHEAST CORNER OF DOWNING STREET AND 28TH AVENUE AT THE TOP OF CURB, ELEVATION = 5229.23, NAVD

CALL UTILITY NOTIFICATION CENTER OF COLORADO
811
CALL 2 BUSINESS DAYS IN ADVANCE BEFORE YOU DIG, GRADE OR EXCAVATE FOR THE MARKING OF UNDERGROUND MEMBER UTILITIES.

No.	Description of Revisions	By	Date
5	WASTEWATER REVISIONS	By	Date
4	ADDENDUM # 4	By	Date
3	CONSTRUCTION DOCUMENTS	By	Date
2	CONSTRUCTION DOCUMENTS	By	Date
1	90% CONSTRUCTION DOCUMENTS	By	Date

Checked By: TJS
Designed By: BSM

RECORD DRAWING

By: Ted Swan for and on behalf of Ware Malcomb
Date: 12/11/2019
Based on information provided by:
Surveyor: Jeffrey J. Mackenna PLS: 34183
Company: Falcon Surveying Inc.
Date(s): 10/29/2019


This "drawing" is a record document prepared from and based upon, in part, information provided by others. Neither Ware Malcomb nor the Engineer of Record has verified the accuracy of this information and shall not be responsible for any errors or omissions which may be incorporated herein as a result.

PLATTE VALLEY APARTMENTS
RENOVATION & ADDITIONS

STORM DETAILS

Date: 08/02/2018
Job No.: 16090
Sheet: C6.4

Sheet of

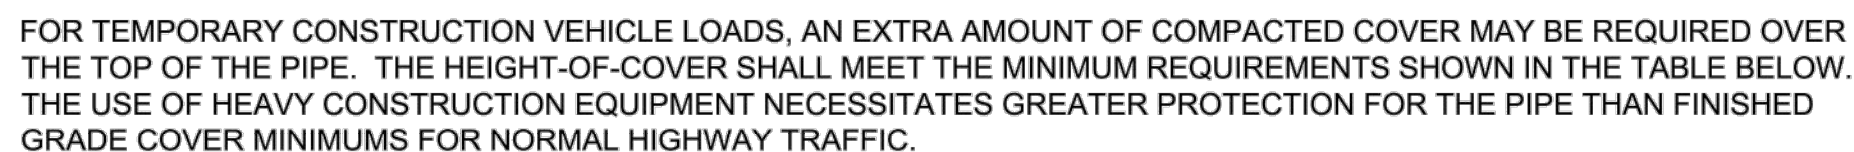

*MINIMUM COVER MAY VARY, DEPENDING ON LOCAL CONDITIONS. THE CONTRACTOR MUST PROVIDE THE ADDITIONAL COVER REQUIRED TO AVOID DAMAGE TO THE PIPE. MINIMUM COVER IS MEASURED FROM THE TOP OF THE PIPE TO THE TOP OF THE MAINTAINED CONSTRUCTION ROADWAY SURFACE.

SCALE: N.T.S.

ALL FABRICATION OF THE PRODUCT SHALL OCCUR WITHIN THE UNITED STATES.

IT IS ALWAYS THE RESPONSIBILITY OF THE CONTRACTOR TO FOLLOW OSHA GUIDELINES FOR SAFE PRACTICES.

SCALE: N.T.S.

The design and information shown on this drawing is provided as a service to the project owner, engineer and contractor by Contech Engineered Solutions LLC ("Contech"). Neither this drawing, nor any part thereof, may be used, reproduced or modified in any manner without the prior written consent of Contech. Failure to comply is done at the user's own risk and Contech expressly disclaims any liability or responsibility for such use.

If discrepancies between the supplied information upon which the drawing is based and actual field conditions are encountered as site work progresses, these discrepancies must be reported to Contech immediately for re-evaluation of the design. Contech accepts no liability for designs based on missing, incomplete or inaccurate information supplied by others.



72, 78"Ø UNDERGROUND DETENTION SYSTEM - 565914-010
DHA PLATTE VALLEY HOUSING - STOUT STREET
DENVER, CO
SITE DESIGNATION: DETENTION VAULT

PROJECT No.: 565914	SEQ. No.: 010	DATE: 02/08/18
DESIGNED: BEB		DRAWN: PDW
CHECKED:		APPROVED:
SHEET NO.: P3 OF 3		



1. DESIGN IN ACCORDANCE WITH AASHTO, 17th EDITION AND ACI 350.
2. DESIGN LOAD HS25.
3. EARTH COVER = 1' MAX.
4. CONCRETE STRENGTH = 4,000 psi
5. REINFORCING STEEL = ASTM A615, GRADE 60.
6. PROVIDE ADDITIONAL REINFORCING AROUND OPENINGS EQUAL TO THE BARS INTERRUPTED, HALF EACH SIDE. ADDITIONAL BARS TO BE IN THE SAME PLANE.



SCALE: N.T.S.


By: Ted Swan for and on behalf of Ware Malcomb
Date: 12/11/2019
Based on information provided by:
Surveyor: Jeffrey J. Mackenna PLS: 34183
Company: Falcon Surveying Inc.
Date(s): 10/29/2019

This "drawing" is a record document prepared from and based upon, in part, information provided by others. Neither Ware Malcomb nor the Engineer of Record has verified the accuracy of this information and shall not be responsible for any errors or omissions which may be incorporated herein as a result.

DS PROJECT NO.		2017-PROJMSTR-0000589 / 2017-SSPR-0000099	
PROJECT NAME:		PLATTE VALLEY APARTMENTS - RENOVATION & ADDITIONS	
DESIGNED BY	BM	DATE	11/22/2017
DRAWN BY	JP	DATE	11/22/2017
CHECKED BY	TLS	DATE	11/22/2017
		SHEET 12 OF 13	
		C6.5	



45 WEST 2ND AVENUE
DENVER, CO 80223
P.303.561.3333
F.303.561.3339

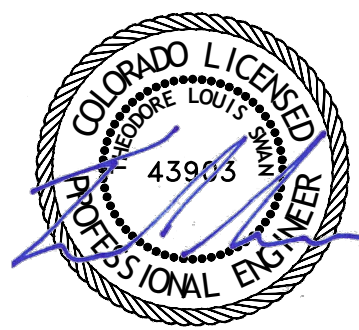

Dec 11, 2019
FOR AND ON BEHALF OF
STRAWN CONSUULTING ENGINEERS

BENCHMARK:

THE BENCHMARK IS A 2" CITY AND
COUNTY OF DENVER BRASS CAP #
373 AR THE SOUTHEAST CORNER OF
DOWNING STREET AND 28TH AVENUE
AT THE TOP OF CURB,
ELEVATION = 5229.23, NAVD

CALL UTILITY NOTIFICATION CENTER
OF COLORADO
811
CALL 2 BUSINESS DAYS IN ADVANCE
BEFORE YOU DIG, GRADE OR EXCAVATE
FOR THE MARKING OF UNDERGROUND
MEMBER UTILITIES.

No.	Description of Revisions	Date	By
5	WASTEWATER REVISIONS	09/26/18	TLS
A	APPENDIX # 4	08/02/18	TLS
3	CONSTRUCTION DOCUMENTS	06/27/18	TLS
2	CONSTRUCTION DOCUMENTS	11/10/17	TLS
1	90% CONSTRUCTION DOCUMENTS	10/06/17	TLS
No.	Description of Revisions	Date	By

PLATTE VALLEY APARTMENTS RENOVATION & ADDITIONS


STORM DETAILS

Date: 08/02/2018
Job No.: 16090
Sheet:

C6.5



Sheet of

RUNOFF SUMMARY						
BASIN LABEL	DESIGN POINT	AREA	LOCAL (CFS)		ACCUMULATIVE (CFS)	
			Q5	Q100	Q5	Q100
C1	1	0.21	0.61	1.44	0.61	1.44
C2	2	0.06	0.13	0.32	0.58	1.36
C3	3	0.01	0.01	0.05	0.01	0.05
C4	4	0.01	0.01	0.05	0.02	0.09
C5	5	0.01	0.01	0.04	0.03	0.13
C6	6	0.01	0.01	0.04	0.03	0.16
C7	7	0.01	0.02	0.07	0.05	0.22
C8	8	0.01	0.02	0.07	0.07	0.29
	9				0.63	1.57
A1	10	0.01	0.02	0.06	0.02	0.06
A2	11	0.01	0.02	0.06	0.04	0.12
A3	12	0.00	0.01	0.02	0.04	0.15
B1	13	0.01	0.01	0.05	0.01	0.05
B2	14	0.01	0.02	0.06	0.03	0.11
B3	15	0.01	0.01	0.04	0.04	0.14
B4		0.06	0.13	0.31	0.13	0.31
B5	17	0.07	0.14	0.33	0.27	0.63
B6	18	0.21	0.62	1.45	0.62	1.45
	19				0.71	1.66
	20				0.73	1.74
	21				1.38	3.38
	22				1.37	3.37
A4	23	0.22	0.68	1.46	0.68	1.46
	24				1.84	4.37

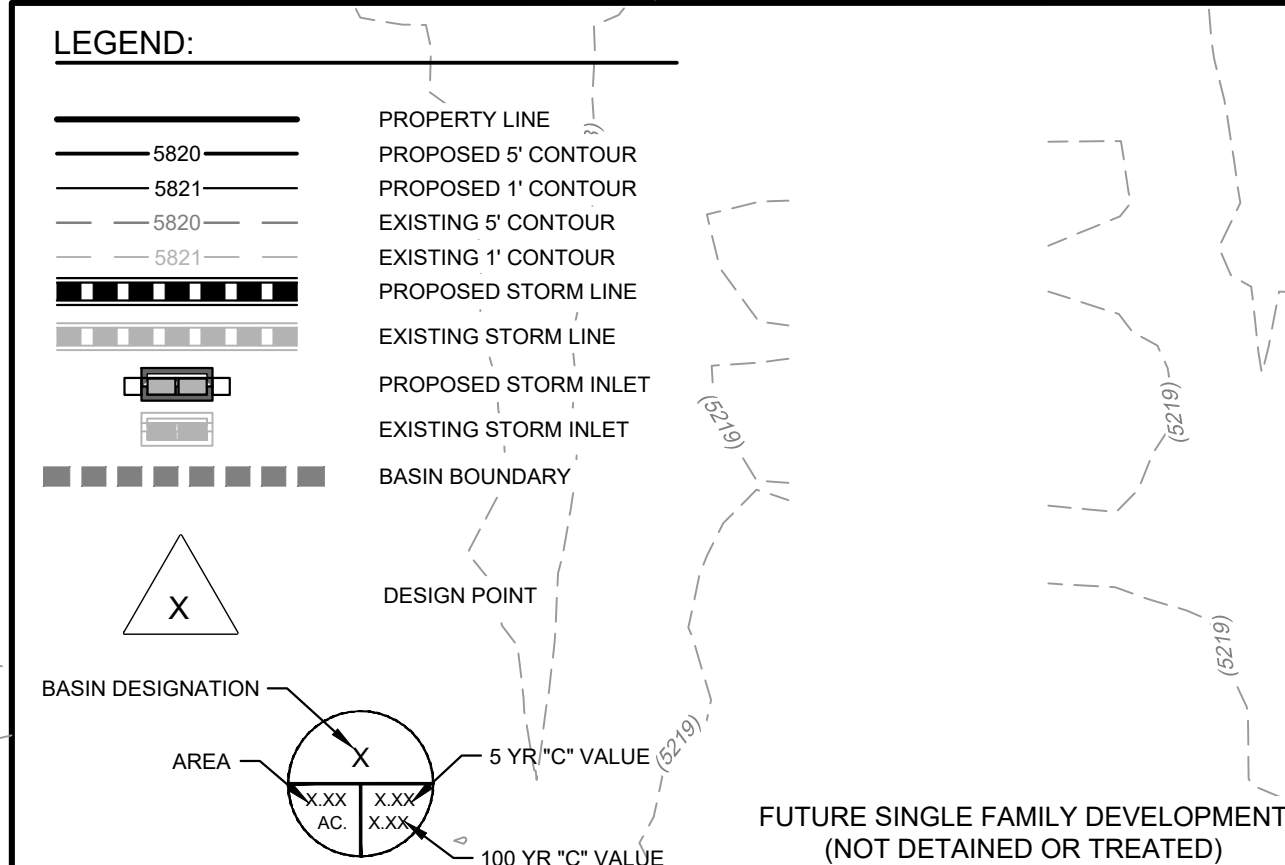


RECORD DRAWING

By: Ted Swan for and on behalf of Ware Malcomb
Date: 12/11/2019
Based on information provided by:
Surveyor: Jeffrey J. Mackenna PLS: 34183
Company: Falcon Surveying Inc.
Date(s): 10/29/2019
This "drawing" is a record document prepared from and based upon, in part, information provided by others. Neither Ware Malcomb nor the Engineer of Record has verified the accuracy of this information and shall not be responsible for any errors or omissions which may be incorporated herein as a result.

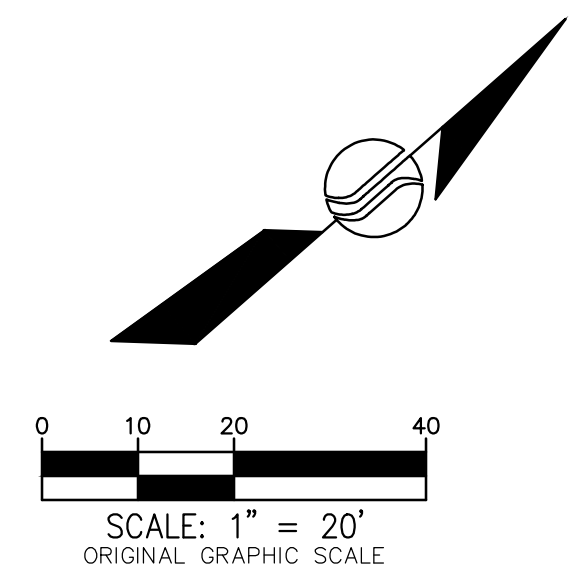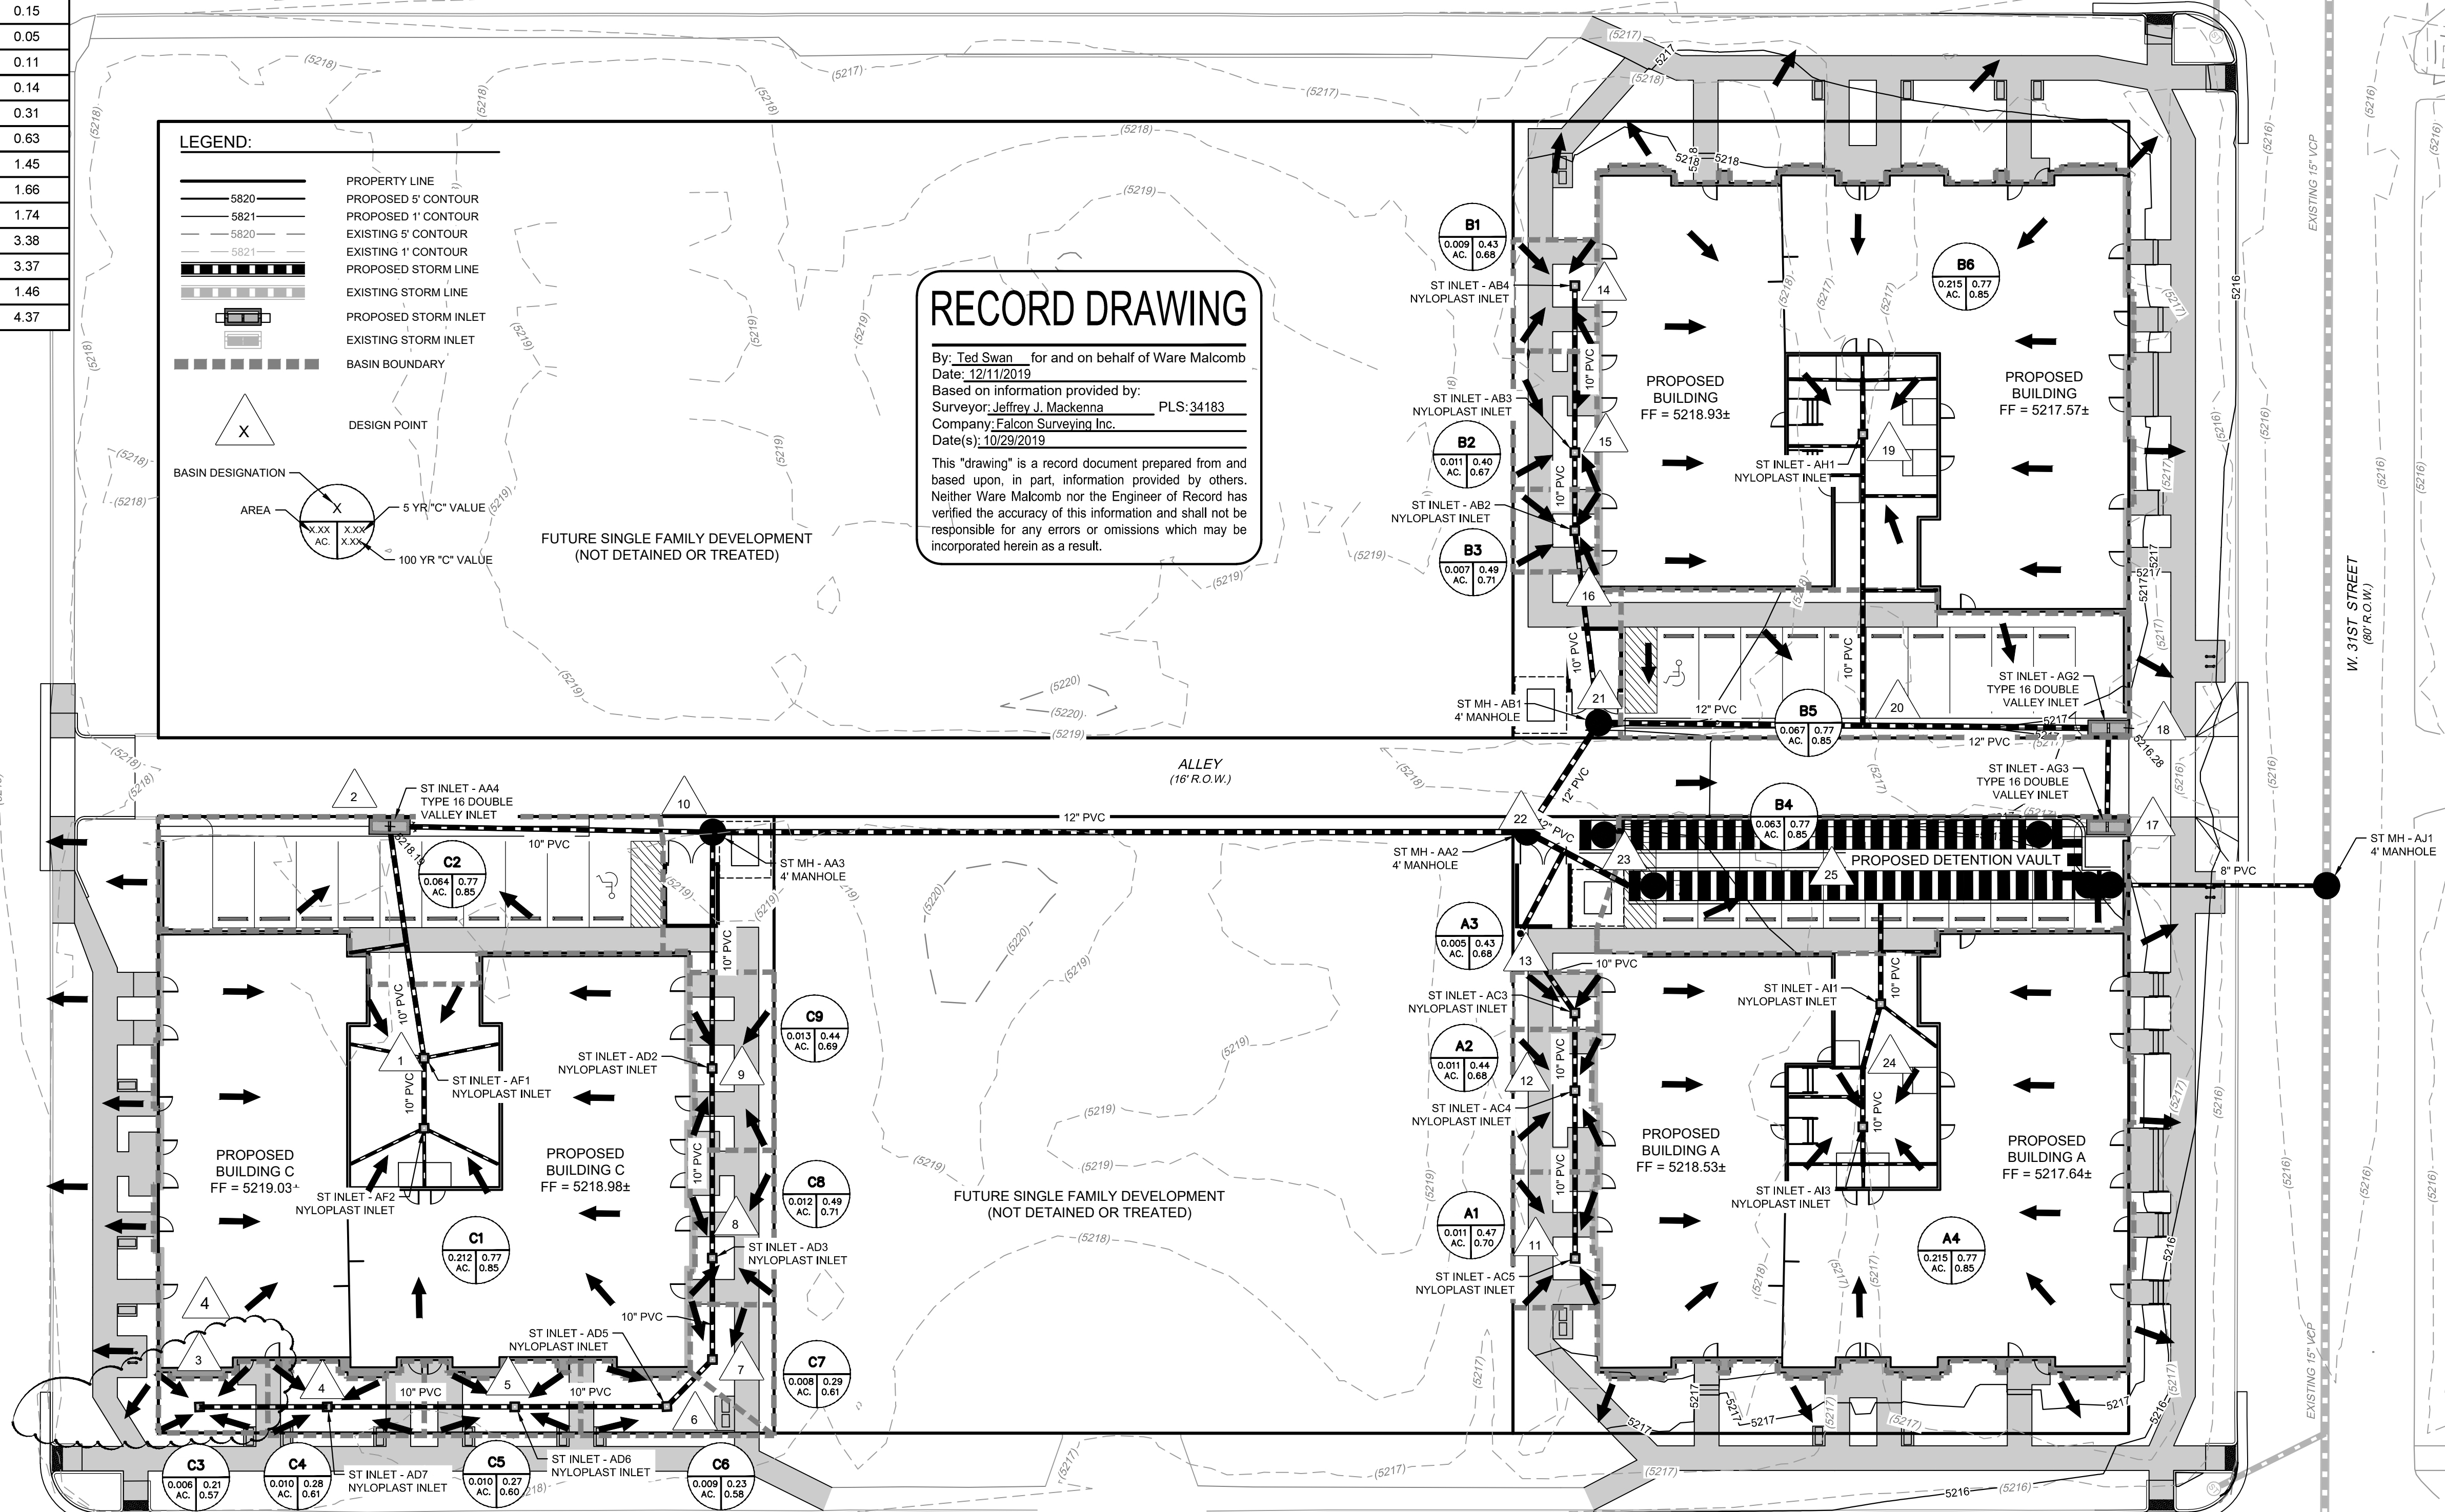

JANSEN STRAWN assumes no responsibility for utility locations. The utilities shown on this drawing have been plotted from the best available information. It is, however, the contractors responsibility to field verify the location of all utilities prior to the commencement of any construction.

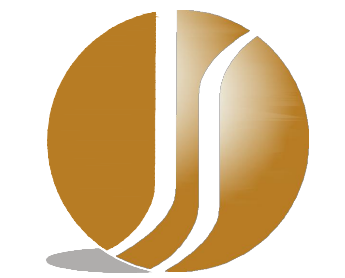

JANSEN STRAWN
CONSULTING ENGINEERS
A WARE MALCOMB Company

45 WEST 2ND AVENUE
DENVER, CO 80223
P. 303.561.3333
F. 303.561.3339



Dec 11, 2019
FOR AND ON BEHALF OF
JANSEN STRAWN CONSULTING ENGINEERS, INC.

BENCHMARK:

THE BENCHMARK IS A 2" CITY AND COUNTY OF DENVER BRASS CAP # 373 AR THE SOUTHEAST CORNER OF DOWNING STREET AND 28TH AVENUE AT THE TOP OF CURB, ELEVATION = 5229.23, NAVD

CALL UTILITY NOTIFICATION CENTER OF COLORADO

811
CALL 2 BUSINESS DAYS IN ADVANCE BEFORE YOU DIG, GRADE OR EXCAVATE FOR THE MARKING OF UNDERGROUND MEMBER UTILITIES.

No.	Description of Revisions	Date	By
1	90% CONSTRUCTION DOCUMENTS	10/06/17	TLS
2	CONSTRUCTION DOCUMENTS	06/27/18	TLS
3	CONSTRUCTION DOCUMENTS	08/02/18	TLS
4	ADDENDUM # 4	08/02/18	TLS
5	WASTEWATER REVISIONS	09/26/18	TLS

PLATTE VALLEY APARTMENTS RENOVATION & ADDITIONS DRAINAGE PLAN

DS PROJECT NO.		2017-PROJMSTR-0000589 / 2017-SSPR-0000099				
PROJECT NAME:		PLATTE VALLEY APARTMENTS - RENOVATION & ADDITIONS				
DESIGNED BY	BM	DATE	11/22/2017	DATE ISSUED	11/22/2017	DRAWING NO.
DRAWN BY	JP	DATE	11/22/2017			
CHECKED BY	TLS	DATE	11/22/2017	SHEET 13 OF 13		DR1

Date: 08/02/2018
Job No.: 16090
Sheet:

DR1

Sheet of

PUBLIC SANITARY CONSTRUCTION PLANS
A PARCEL LOCATED IN THE SOUTHWEST QUARTER OF SECTION 26,
TOWNSHIP 3 SOUTH, RANGE 68 WEST OF THE SIXTH PRINCIPAL MERIDIAN,
CITY AND COUNTY OF DENVER, STATE COLORADO



C1.1 WASTEWATER COVER SHEET & NOTES
C3.0 SANITARY PLAN & PROFILE

This "drawing" is a record document prepared from and based upon, in part, information provided by others. Neither Ware Malcomb nor the Engineer of Record has verified the accuracy of this information and shall not be responsible for any errors or omissions which may be incorporated herein as a result.

THESE CONSTRUCTION DRAWINGS FOR **PLATTE VALLEY APARTMENTS - RENOVATION & ADDITIONS** WERE PREPARED BY ME (OR UNDER MY DIRECT SUPERVISION) IN ACCORDANCE WITH THE REQUIREMENTS OF THE STORM DRAINAGE AND SANITARY CONSTRUCTION DETAILS AND TECHNICAL SPECIFICATIONS AND THE STORM DRAINAGE DESIGN AND TECHNICAL CRITERIA OF THE CITY AND COUNTY OF DENVER.


NO WORK IS AUTHORIZED WITHOUT
A PRE-CONSTRUCTION MEETING AT
WHICH YOU WILL RECEIVE A COPY
OF THE CITY AND COUNTY OF
DENVER STAMPED AND APPROVED
SET OF PLANS

PLEASE CALL 303-446-3722 TO
SCHEDULE A PRE-CONSTRUCTION
MEETING AFTER YOUR PLANS HAVE
BEEN APPROVED



JANSEN STRAWN
CONSULTING ENGINEERS
A WARE MALCOMB Company

45 WEST 2ND AVENUE
DENVER, CO 80223
P.303.561.3333
F.303.561.3339

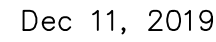

THE BENCHMARK IS A 2" CITY AND
COUNTY OF DENVER BRASS CAP #
373 AR THE SOUTHEAST CORNER OF
DOWNING STREET AND 28TH AVENUE
AT THE TOP OF CURB,
ELEVATION = 5229.23, NAVD

[illegible]

PLATTE VALLEY APARTMENTS RENOVATION & ADDITIONS

WASTEWATER COVER SHEET & NOTES


Date: 04/29/19

Job No.: 16090

Sheet:


C1.1

Sheet 01

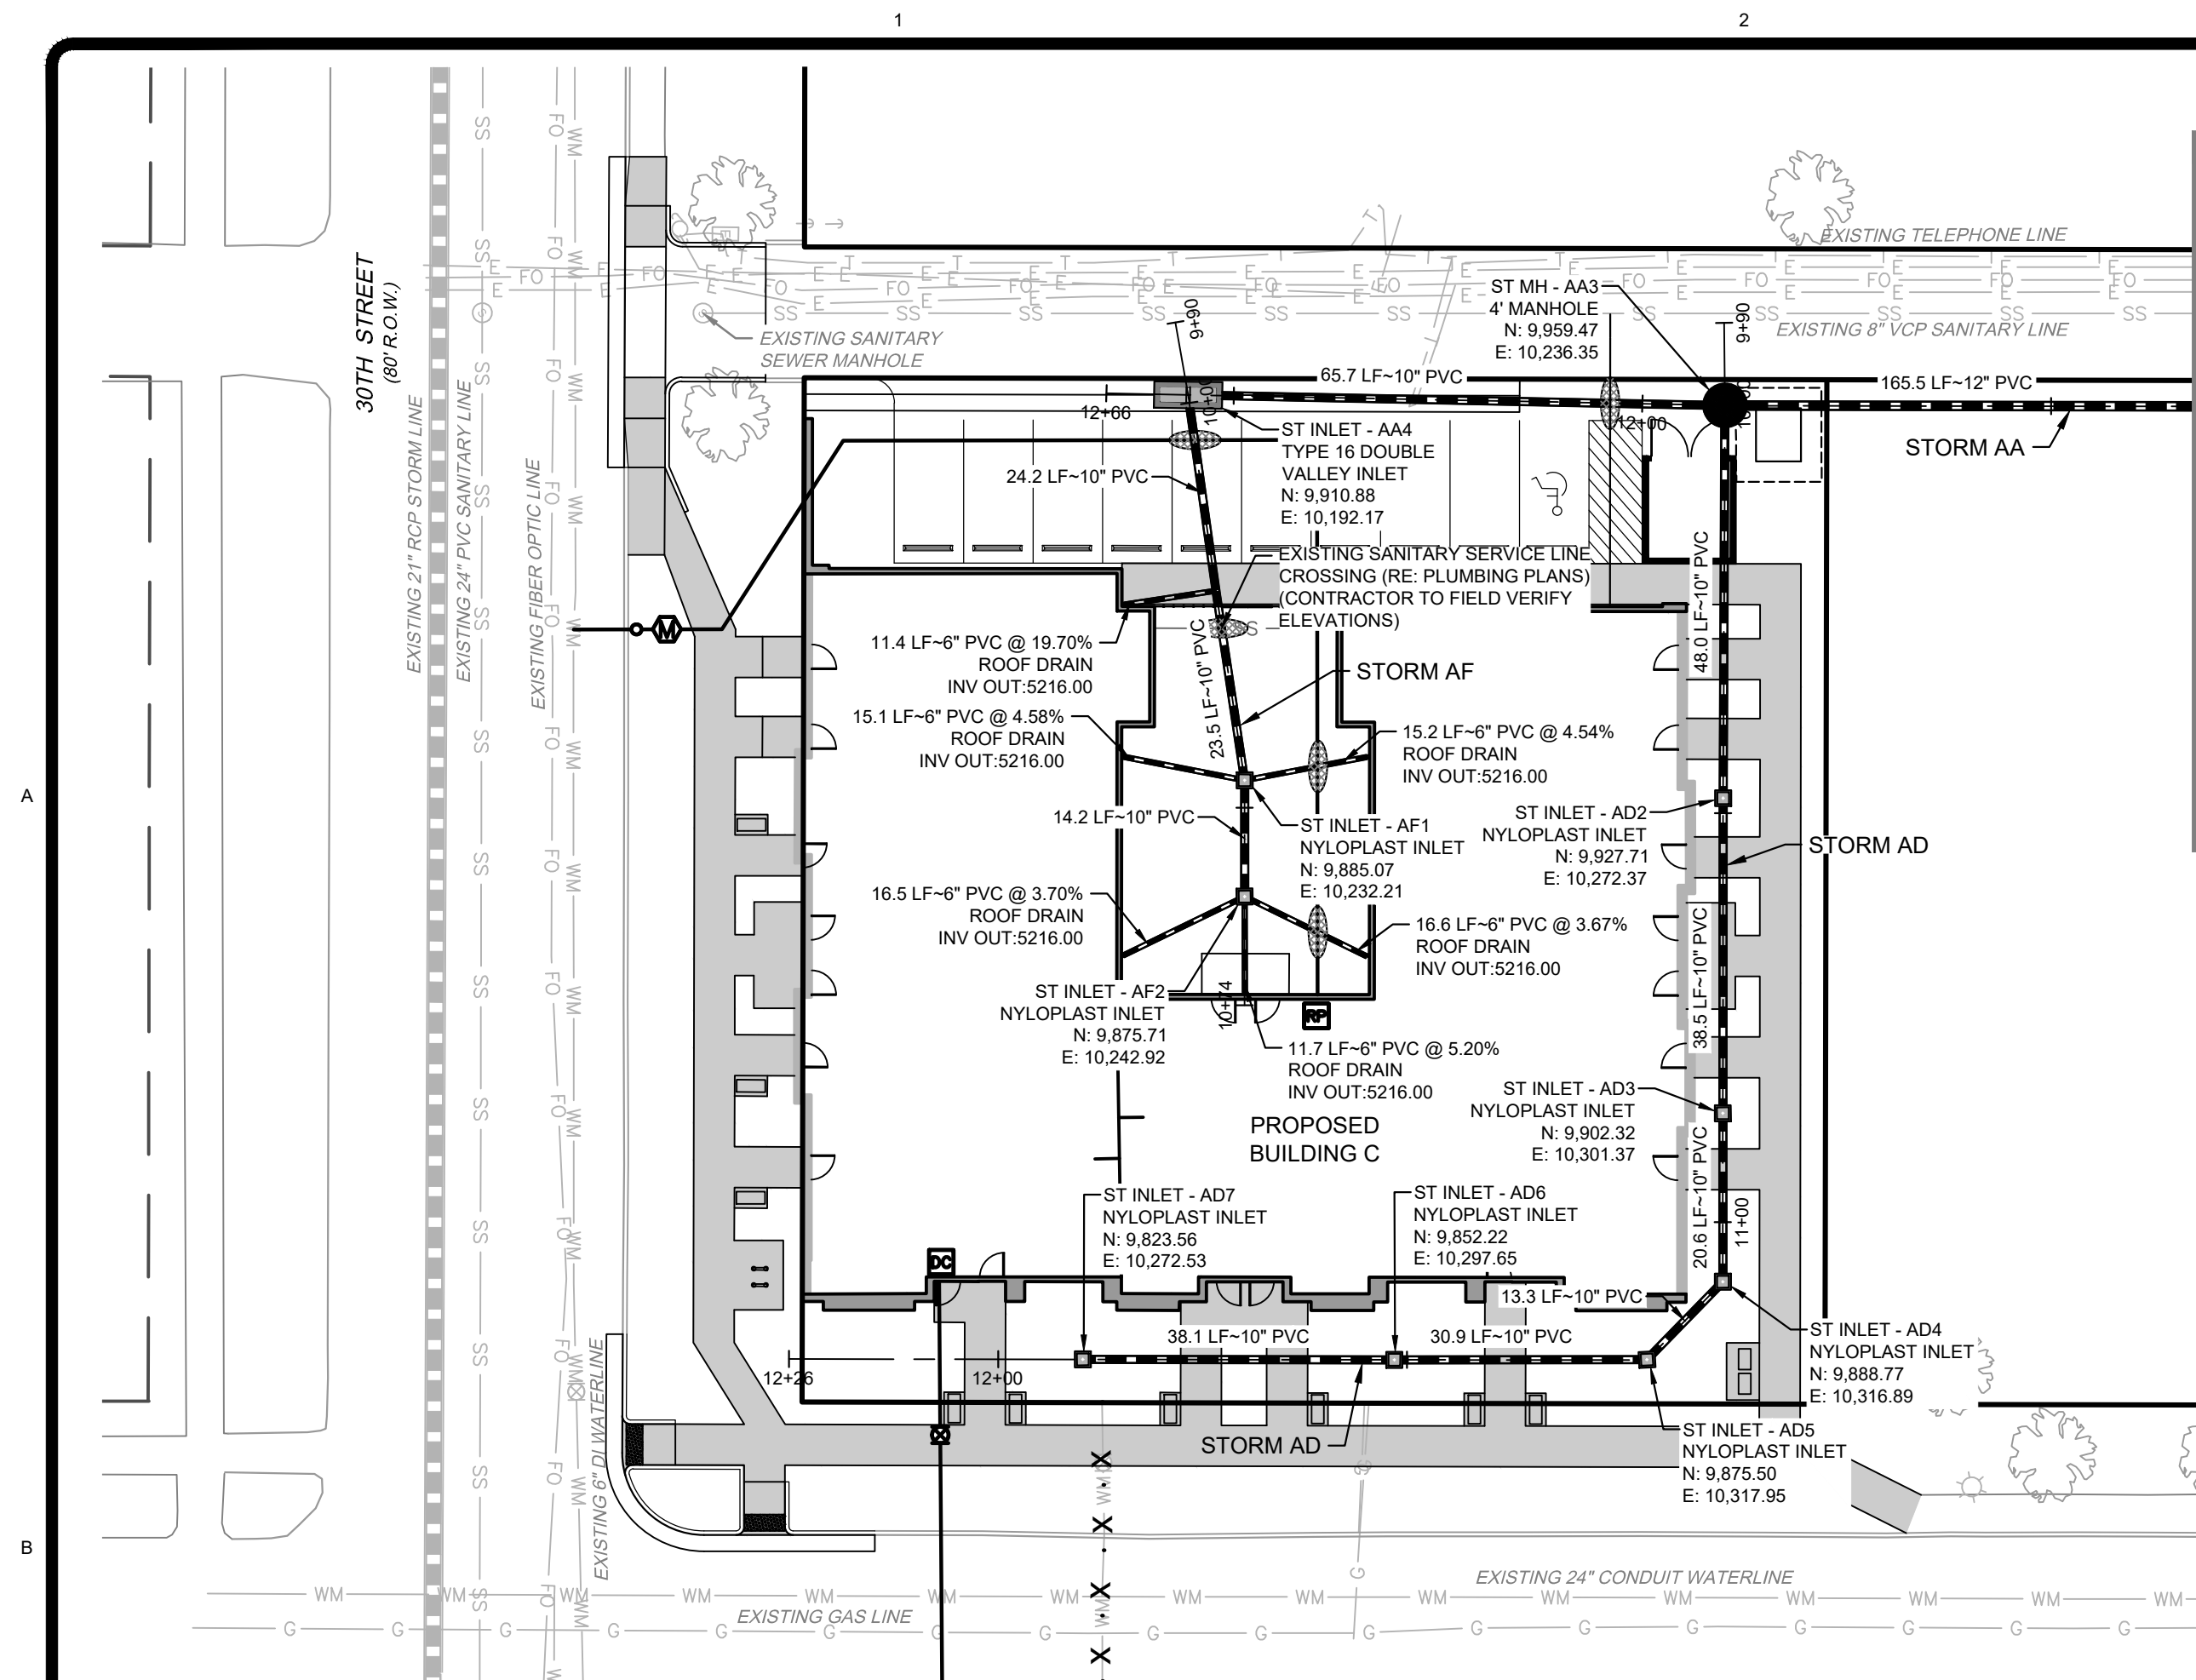

UTILITY LEGEND:


	PROPERTY LINE		EXISTING GAS LINE
	UTILITY CROSSING		EXISTING TELEPHONE LINE
	PROPOSED STORM LINE		EXISTING ELECTRIC LINE
	PROPOSED STORM INLET		EXISTING CABLE TV LINE
	EXISTING STORM LINE		EXISTING OVERHEAD LINE
	EXISTING STORM INLET		EXISTING FIBER OPTIC LINE
	PROPOSED SANITARY LINE W/ MANHOLE		EXISTING IRRIGATION LINE
	EXISTING SANITARY LINE W/ MANHOLE		EXISTING SPRINKLER CONTROL
	PROPOSED WATERLINE & VALVE		PROPOSED LIGHT POLE
	PROPOSED FIRE HYDRANT ASSEMBLY		EXISTING LIGHT POLE
	EXISTING WATERLINE & VALVE		
	EXISTING FIRE HYDRANT		

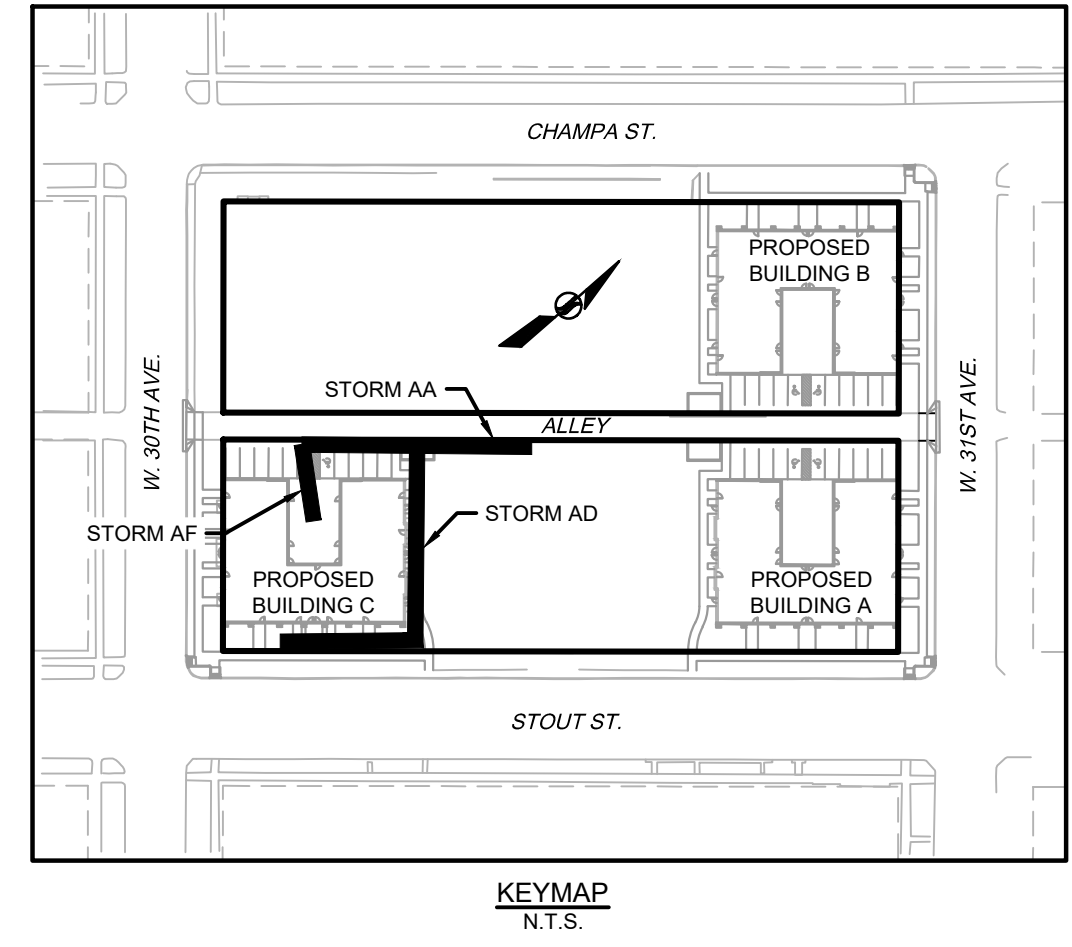

DS PROJECT NO.		2017-PROJMSTR-0000589 / 2017-SSPR-0000099				
PROJECT NAME:		PLATTE VALLEY APARTMENTS - RENOVATION & ADDITIONS				
DESIGNED BY	BM	DATE	11/22/2017	DATE ISSUED	11/22/2017	DRAWING NO.
DRAWN BY	JP	DATE	11/22/2017			C6.0
CHECKED BY	TLS	DATE	11/22/2017	SHEET 7 OF 13		

ALL STORM PIPES, INLETS, AND MANHOLES ARE PRIVATE

- NOTES:
- 1) THE CONTRACTOR IS TO VERIFY THE ELEVATION OF ALL EXISTING UTILITIES WHERE NEW WORK WILL CONNECT AND NOTIFY THE ENGINEER IF THERE ARE ANY DISCREPANCIES.
 - 2) INLETS ARE CONTROLLED AT CENTER OF BOX AT FLOWLINE.
 - 3) MANHOLES ARE CONTROLLED AT CENTER OF MANHOLE.
 - 4) ALL STORM LINES TO BE CLASS III REINFORCED CONCRETE UNLESS OTHERWISE NOTED.



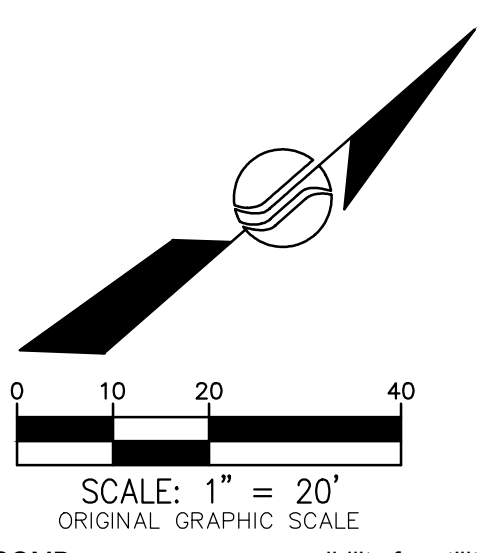


WARE MALCOMB assumes no responsibility for utility locations. The utilities shown on this drawing have been plotted from the best available information. It is, however, the contractors responsibility to field verify the location of all utilities prior to the commencement of any construction.

RECORD DRAWING


By: Ted Swan for and on behalf of Ware Malcomb
 Date: 12/11/2019
 Based on information provided by:
 Surveyor: Jeffrey J. Mackenna PLS: 34183
 Company: Falcon Surveying Inc.
 Date(s): 10/29/2019

This "drawing" is a record document prepared from and based upon, in part, information provided by others. Neither Ware Malcomb nor the Engineer of Record has verified the accuracy of this information and shall not be responsible for any errors or omissions which may be incorporated herein as a result.

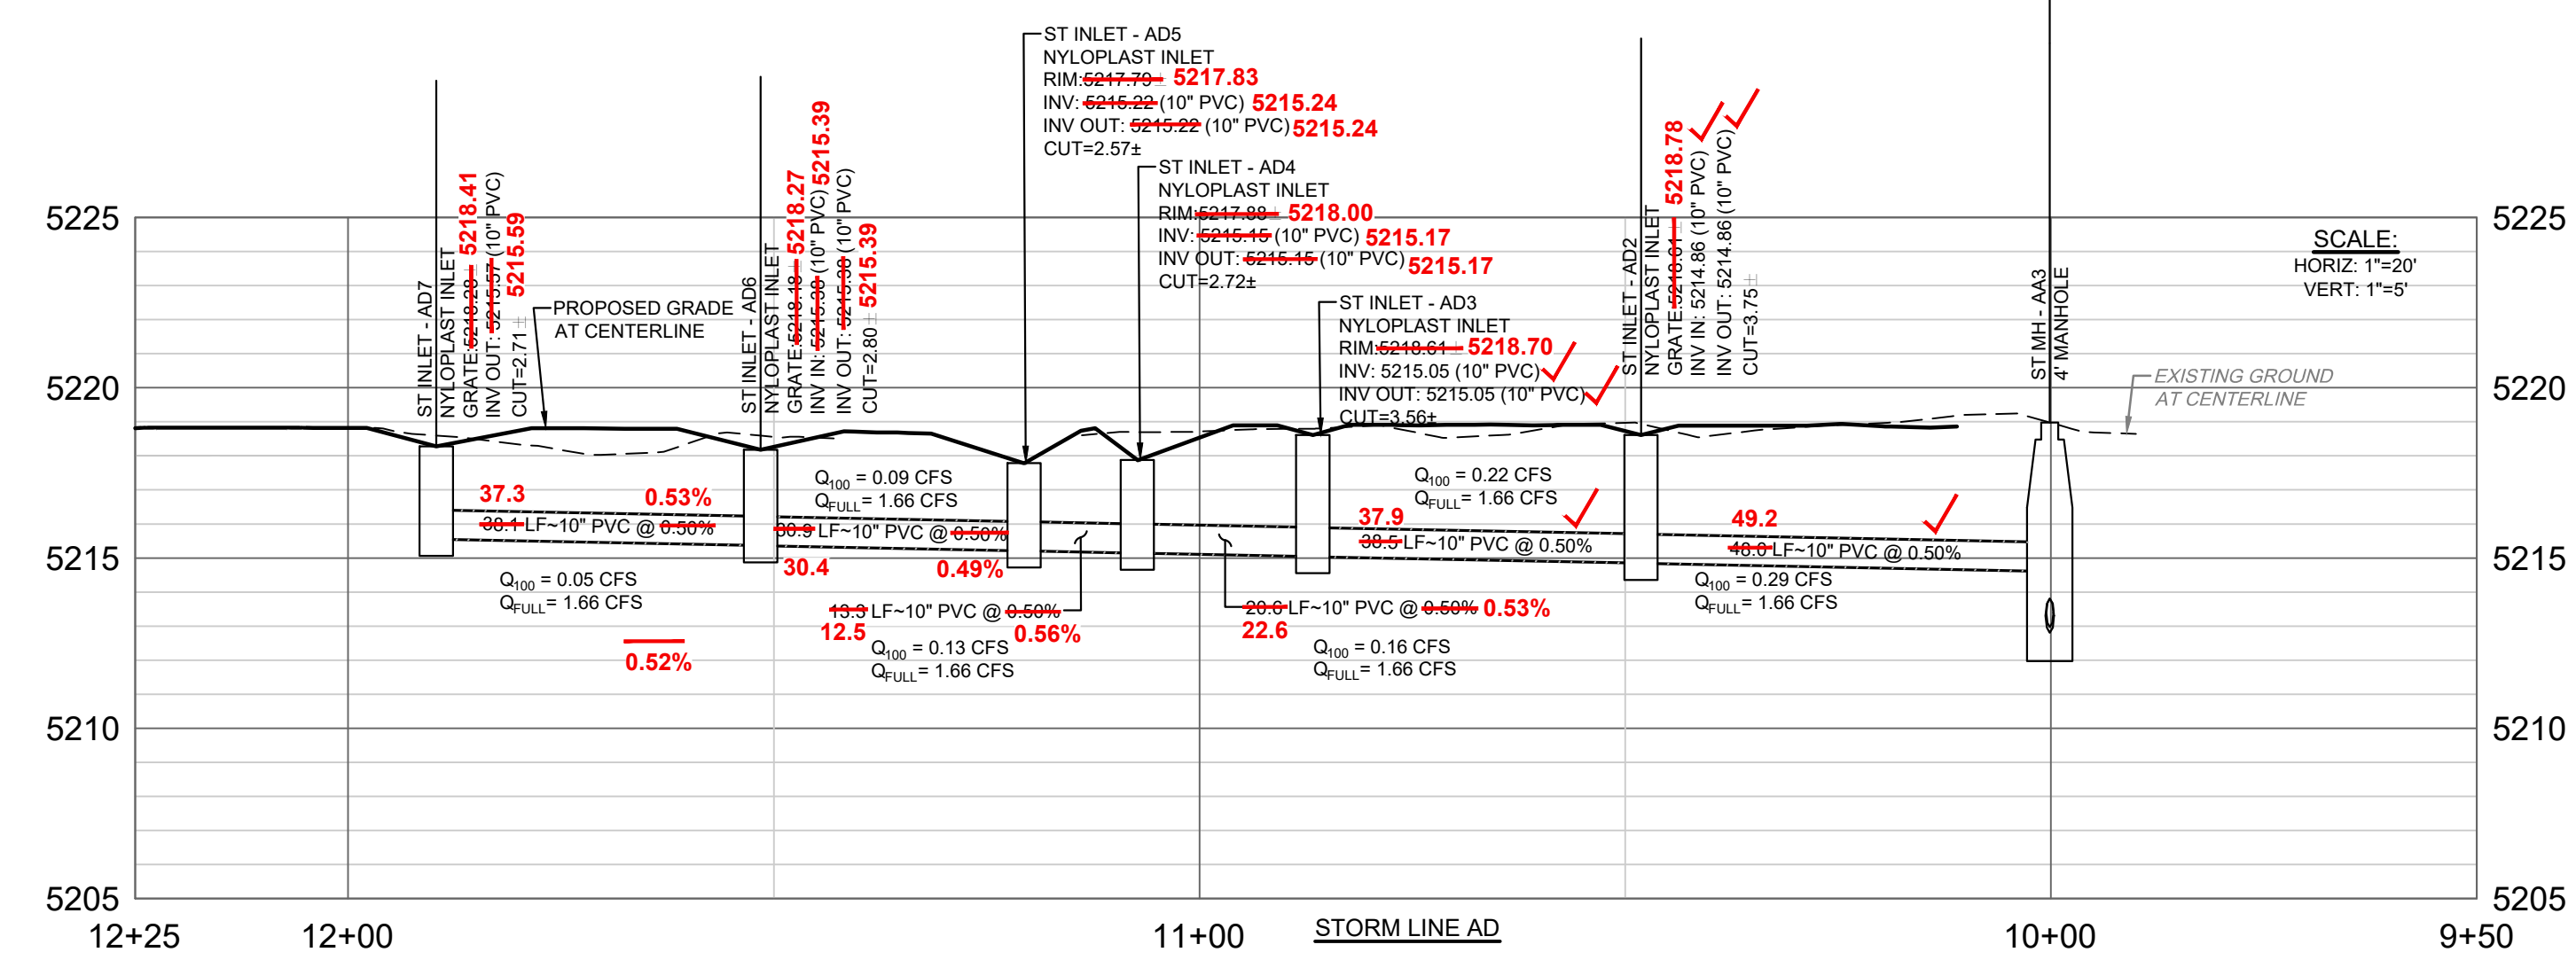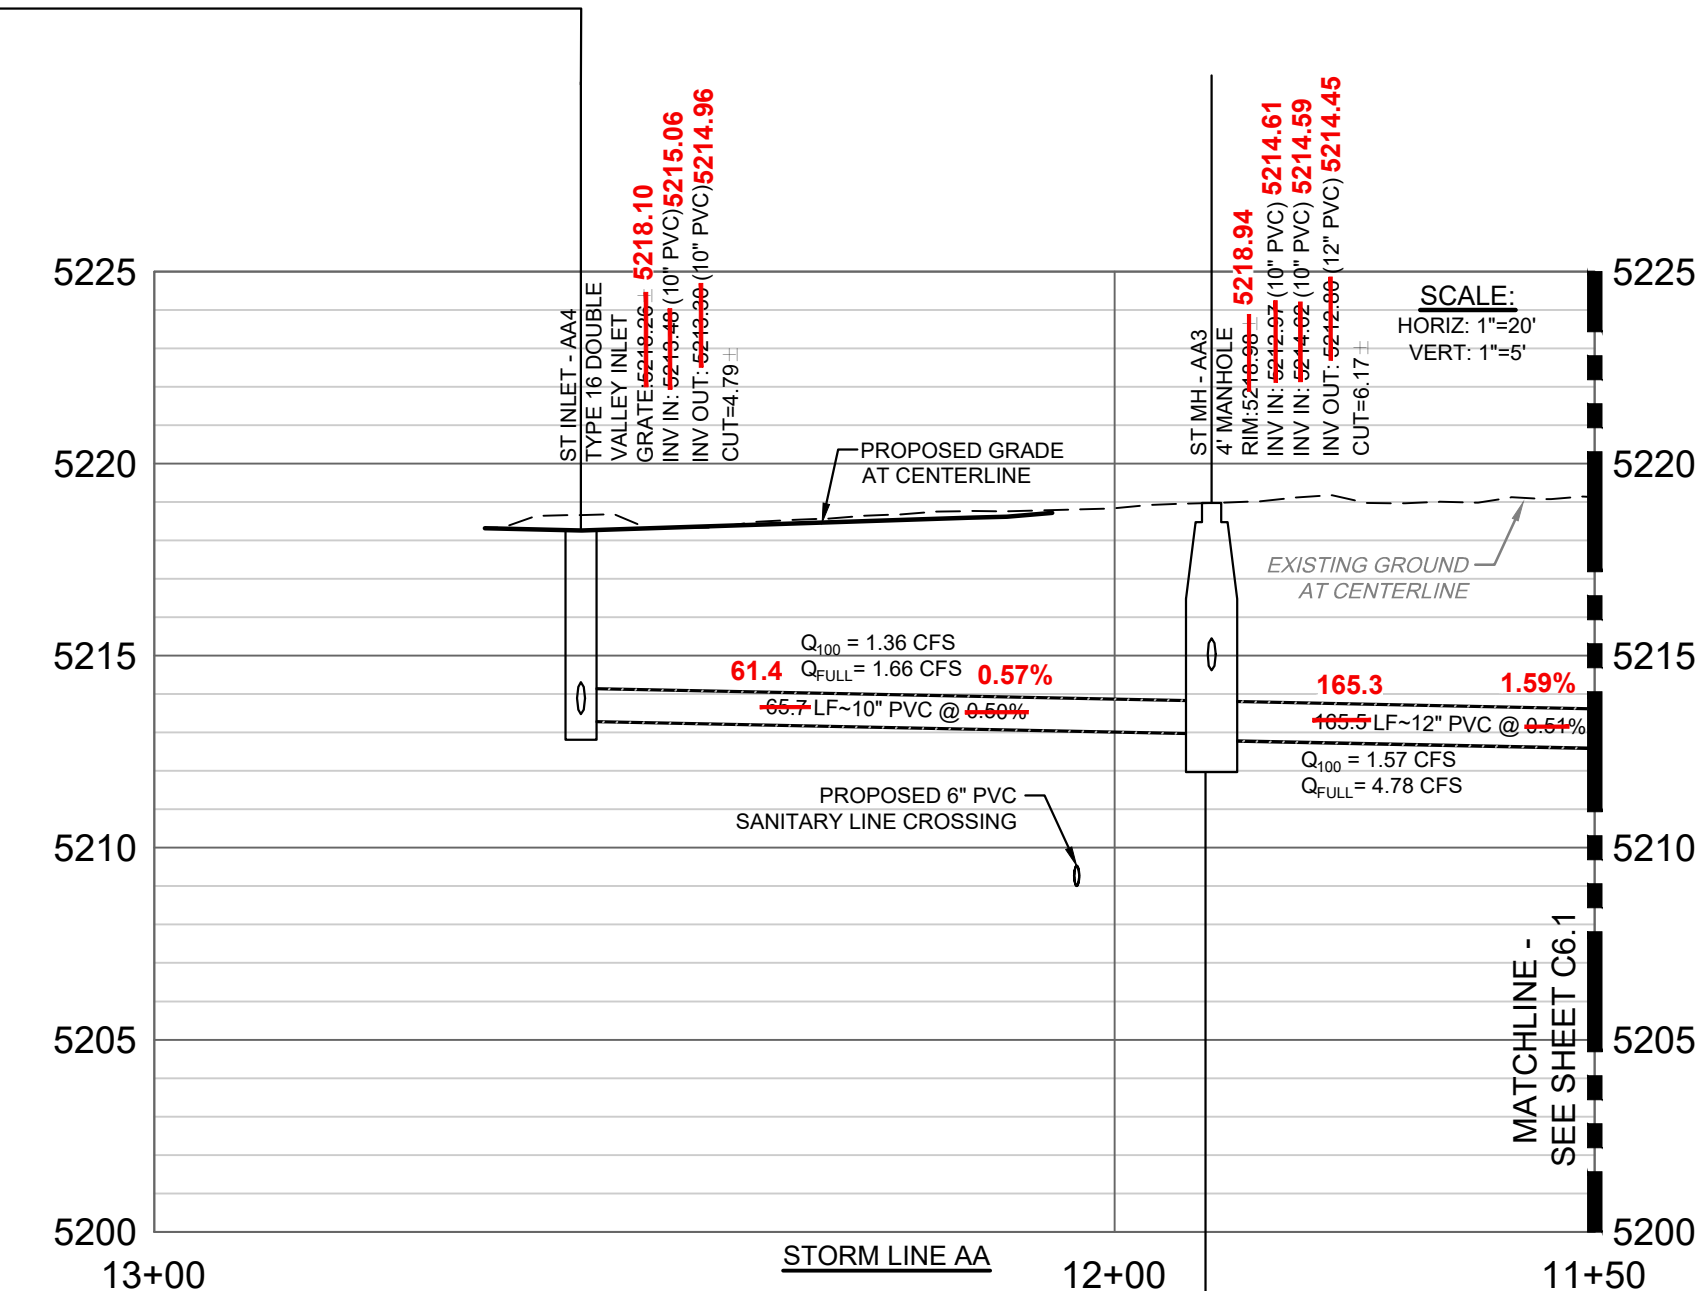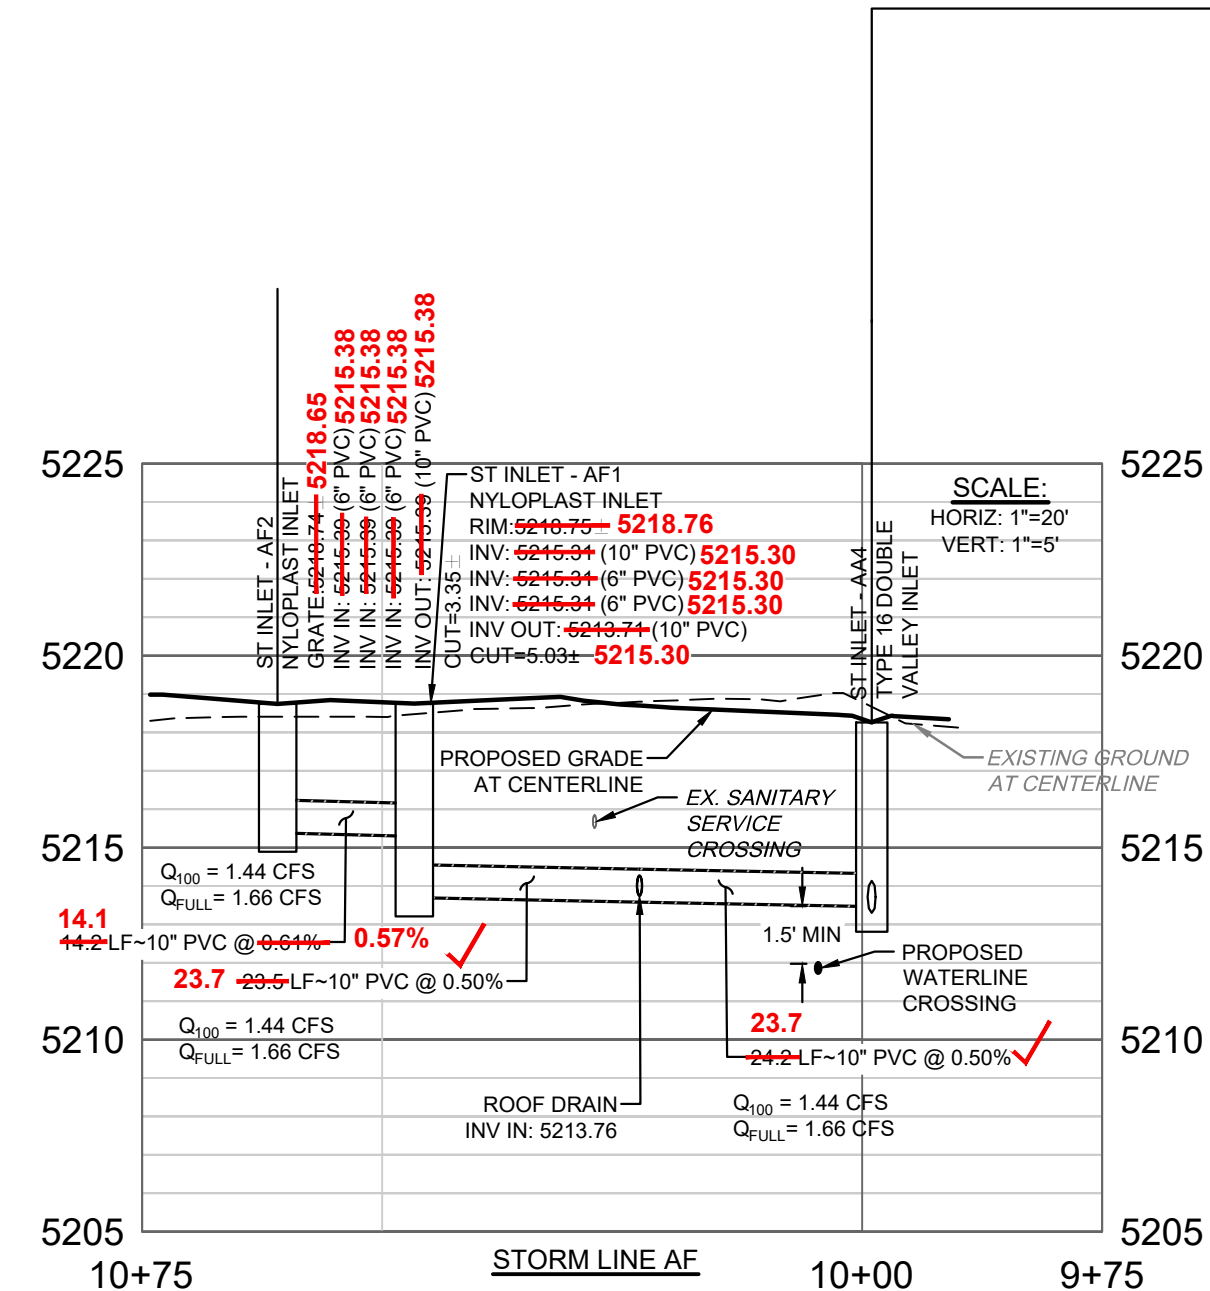

JANSEN STRAWN
 CONSULTING ENGINEERS
 A WARE MALCOMB Company

45 WEST 2ND AVENUE
 DENVER, CO 80223
 P.303.561.3333
 F.303.561.3339

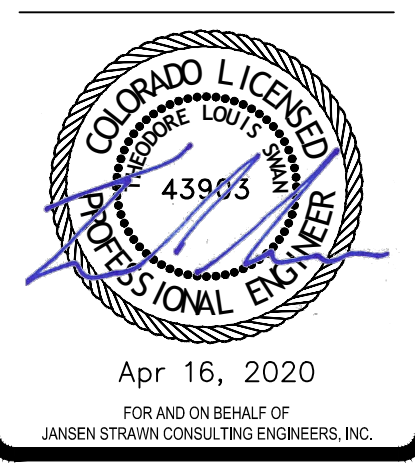

BENCHMARK:

THE BENCHMARK IS A 2" CITY AND COUNTY OF DENVER BRASS CAP # 373 AR THE SOUTHEAST CORNER OF DOWNING STREET AND 28TH AVENUE AT THE TOP OF CURB. ELEVATION = 5229.23, NAVD

CALL UTILITY NOTIFICATION CENTER OF COLORADO
811
 CALL 2 BUSINESS DAYS IN ADVANCE BEFORE YOU DIG, GRADE OR EXCAVATE FOR THE MARKING OF UNDERGROUND MEMBER UTILITIES

No.	Description of Revisions	Date	By
5	WASTEWATER REVISIONS	09/26/18	TLS
4	ADDENDUM # 4	08/02/18	TLS
3	CONSTRUCTION DOCUMENTS	06/27/18	TLS
2	CONSTRUCTION DOCUMENTS	11/10/17	TLS
1	90% CONSTRUCTION DOCUMENTS	10/06/17	TLS

Designed By: BSM
 Checked By: TLS

PLATTE VALLEY APARTMENTS
RENOVATION & ADDITIONS

STORM PLAN & PROFILE

Date: 08/02/2018
 Job No.: 16090
 Sheet:

C6.0

Sheet of